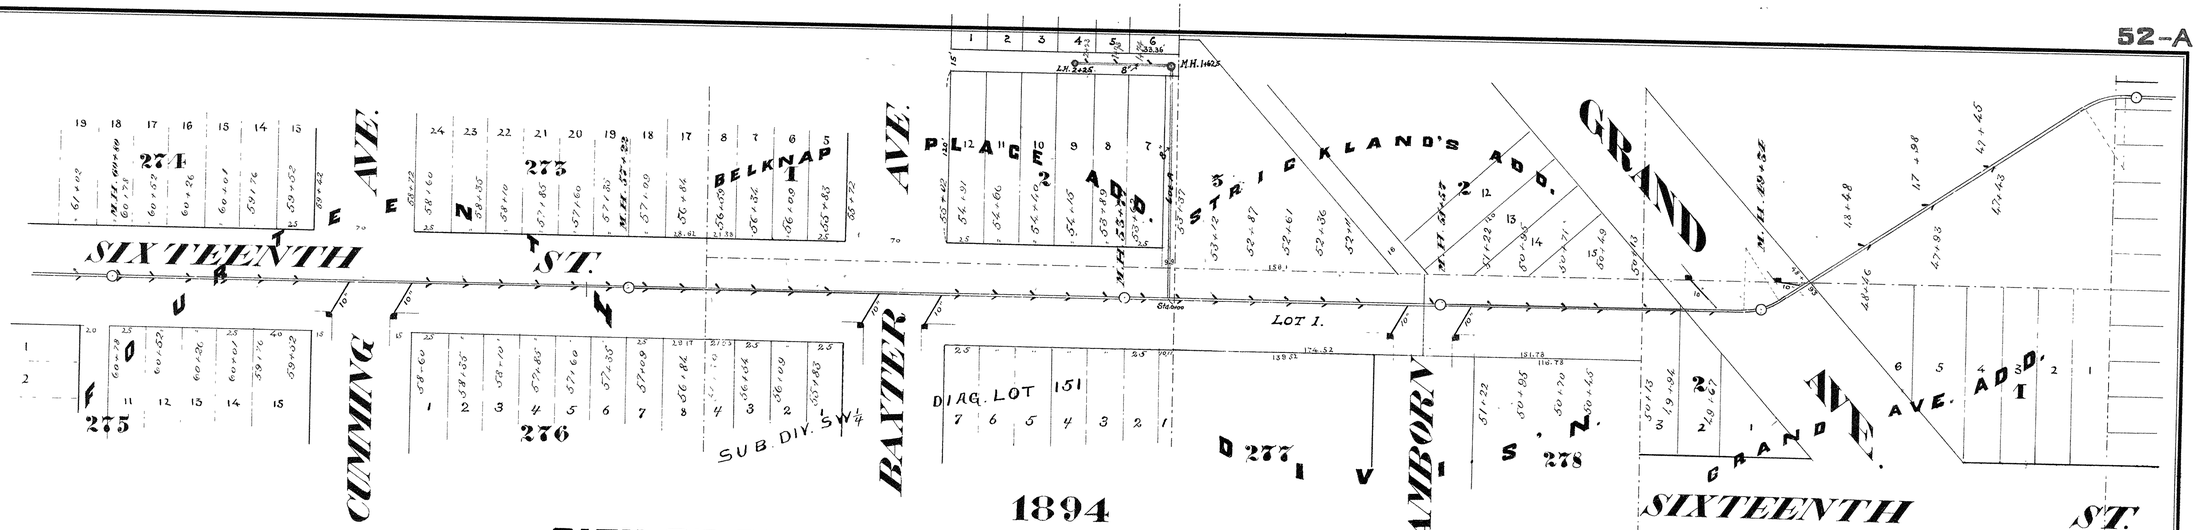

CITY OF SUPERIOR

SEWER PLAN

Contract let June 13, 1890
" completed June 1, 1891
Kirkland & Starkey, Contractors
John Bailey, Inspector
E. B. Banks, City Engr.

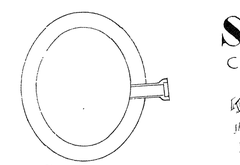

Section of 4'3"x5'6" Sewer

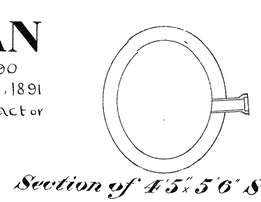

Section of 4'5"x5'6" Sewer

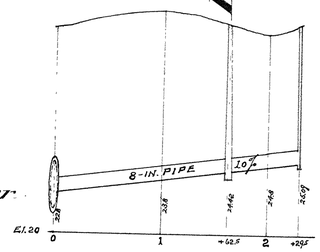

Section of 5'6" Sewer

Scale: { Horizontal 60'=1"
Vertical 4'=1"
Section 4'=1"

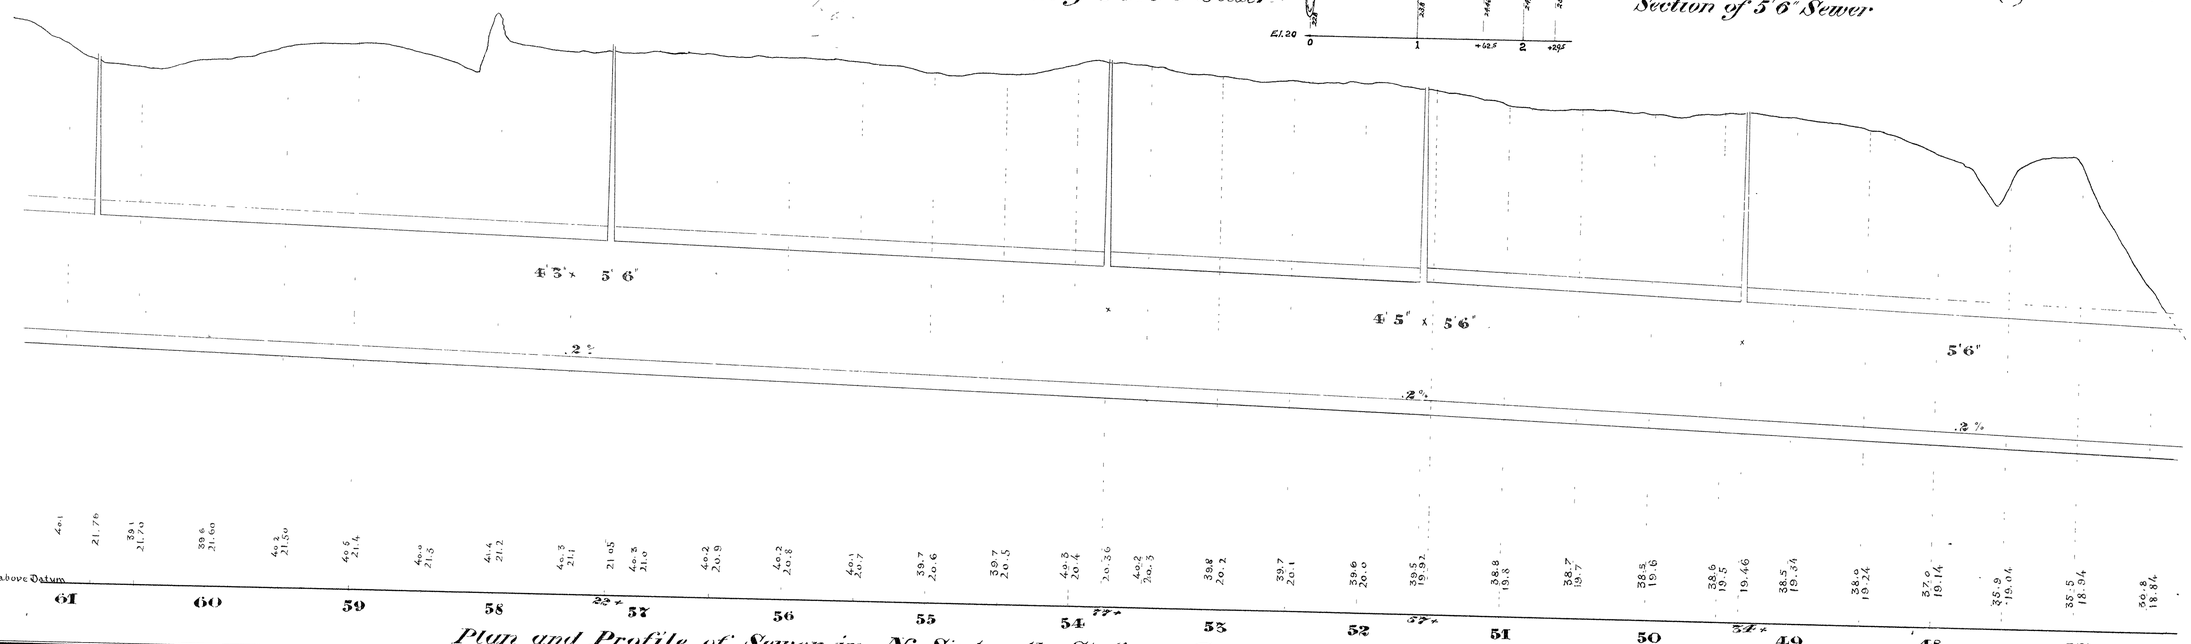

Plan and Profile of Sewer in N. Sixteenth St. from Grand Ave. to Alley betw. Cumming and Hammond Ave. 2B-52A