Void

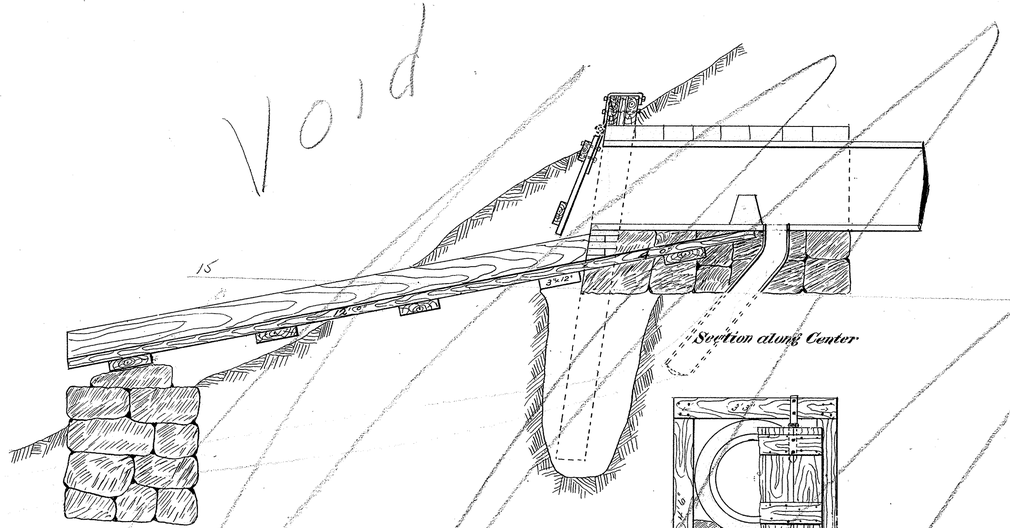

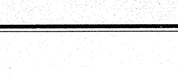

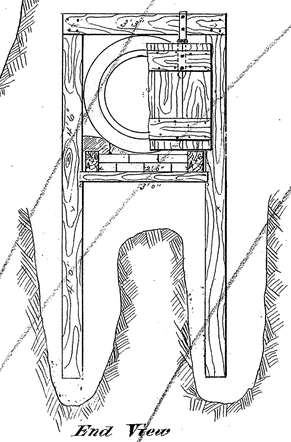

Details of Outlet of Sewer in Alleys betw. W. 6th & 7th and 7th & 8th Strs.

Scale: Horizontal 1" = 60'; Vertical 1" = 4'; Section 1" = 2'

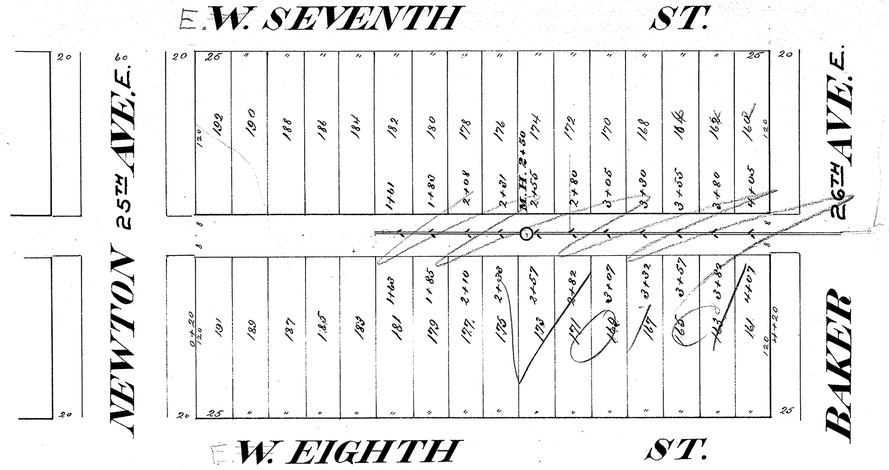

THIS SEWER WAS
RELAID MAY 1937
SEE MAP 4-35A

CITY OF SUPERIOR

SEWER PLAN

Contract let June 1, 1891
" completed Aug. 1891
Stockton & Lundquist, Contractor
Jos. P. Duff, Inspector
E. B. Banks, City Engr.

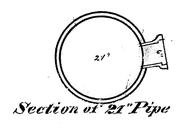

Section of 21" Pipe

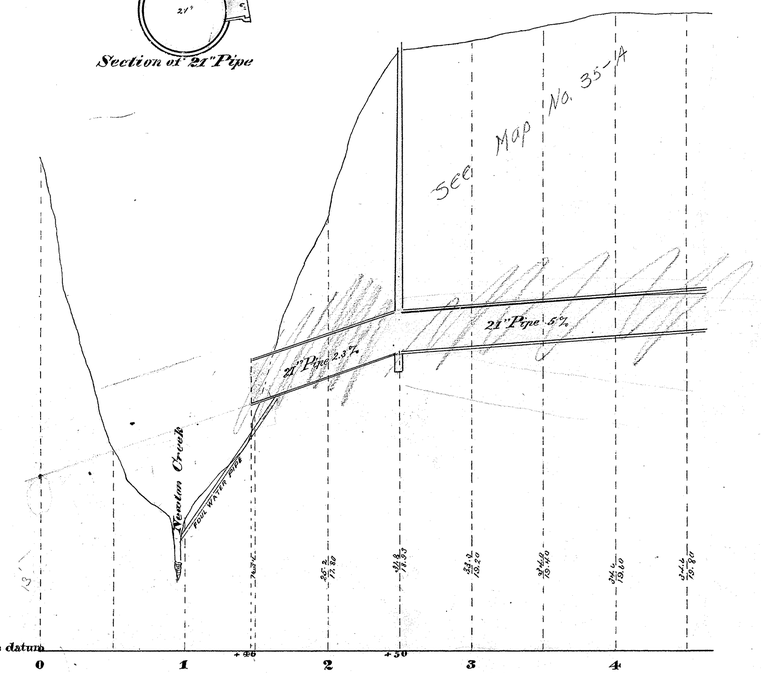

Plan & Profile of Sewer in Alley betw. W. 7th & 8th Sts.

4-35