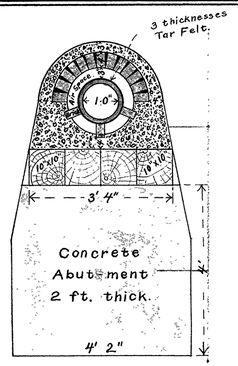

Section A–B.

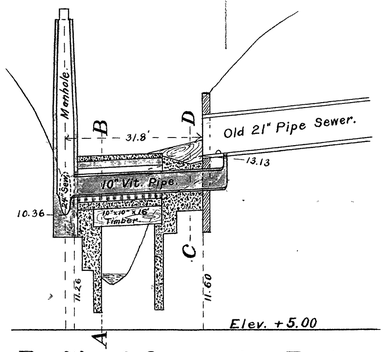

Profile of Connection East in Alley between 6th & 7th Sts.

Horizontal Scale, 1"=20' — Vertical, 1"=4'.

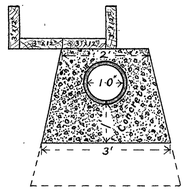

Section C–D.

CITY OF SUPERIOR

SEWER PLAN

Contract let July 21, 1904.

" completed Nov. 10, "

Anderson & Johnson, Contractors.

F. Richardson, Inspector.

Howard Thomas, City Engineer.

Scale: Horizontal : 1" = 60'. Vertical : 1" = 4'. Section : 1" = 2'.

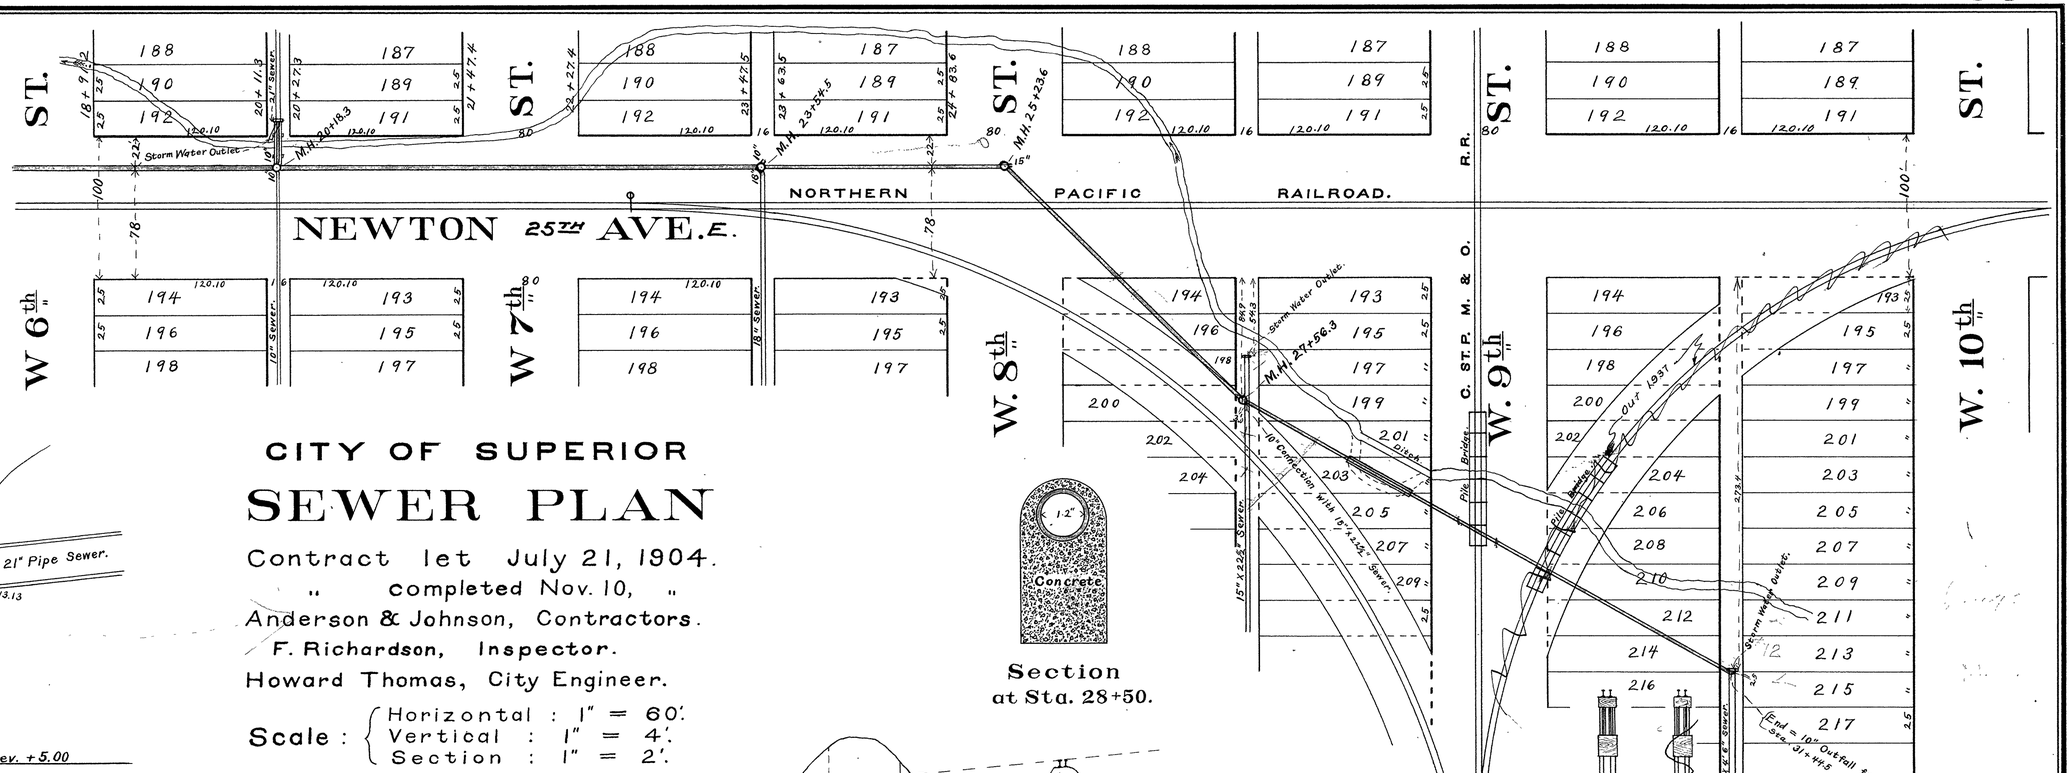

Section at Sta. 28+50.

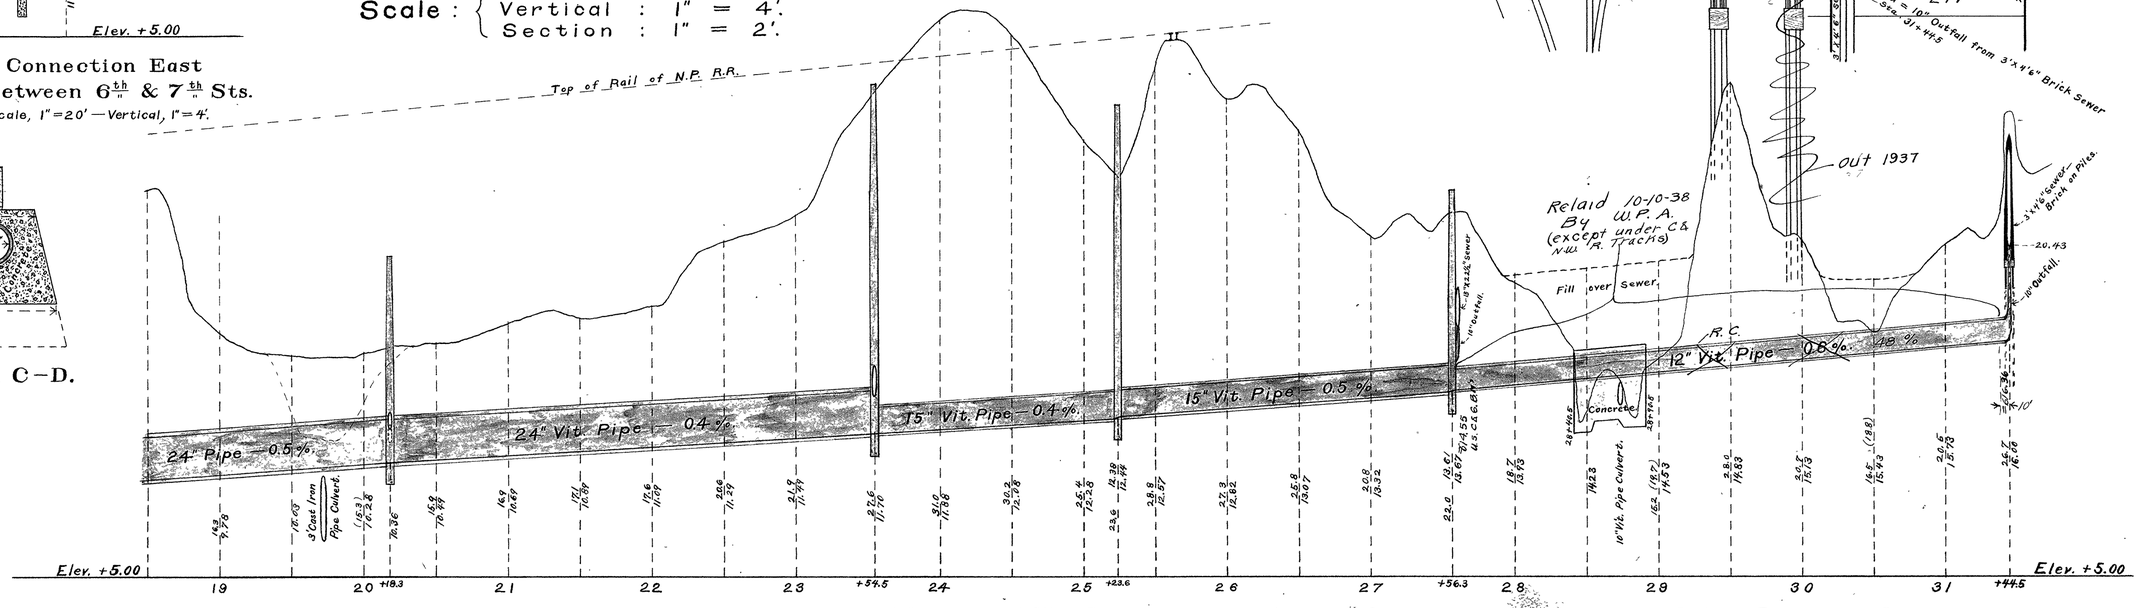

PROFILE OF SEWER IN NEWTON AVE. FROM W. 6TH TO 8TH STS. AND W. TO SEWERS BETWEEN 8TH & 10TH STS.

4-39

Mar. 1905. S. M. White, Del.