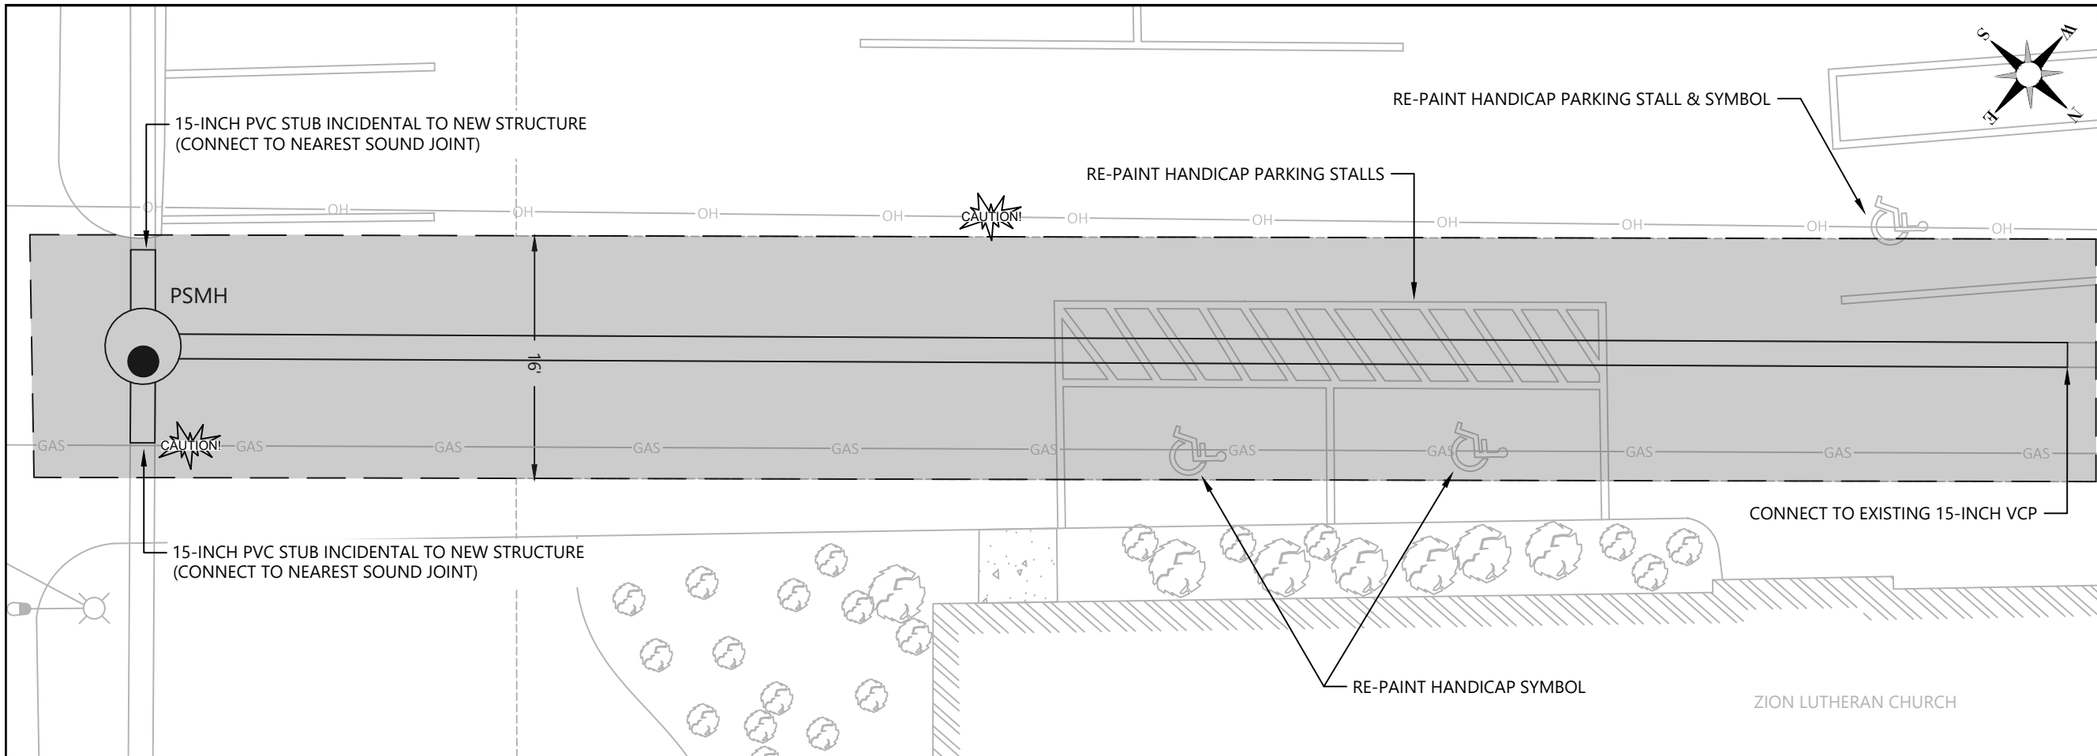

PROPOSED ASHPALT

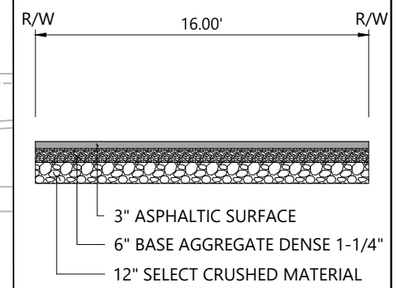

TYPICAL FINISHED SECTION

NOT TO SCALE

ID	ELEVATIONS	TYPE
PSMH	RIM: 628.07	4-FT DIA. PRECAST
	INV IN (NW): 616.88	
	INV IN (SW): 617.05	
	INV OUT (NE): 616.78	

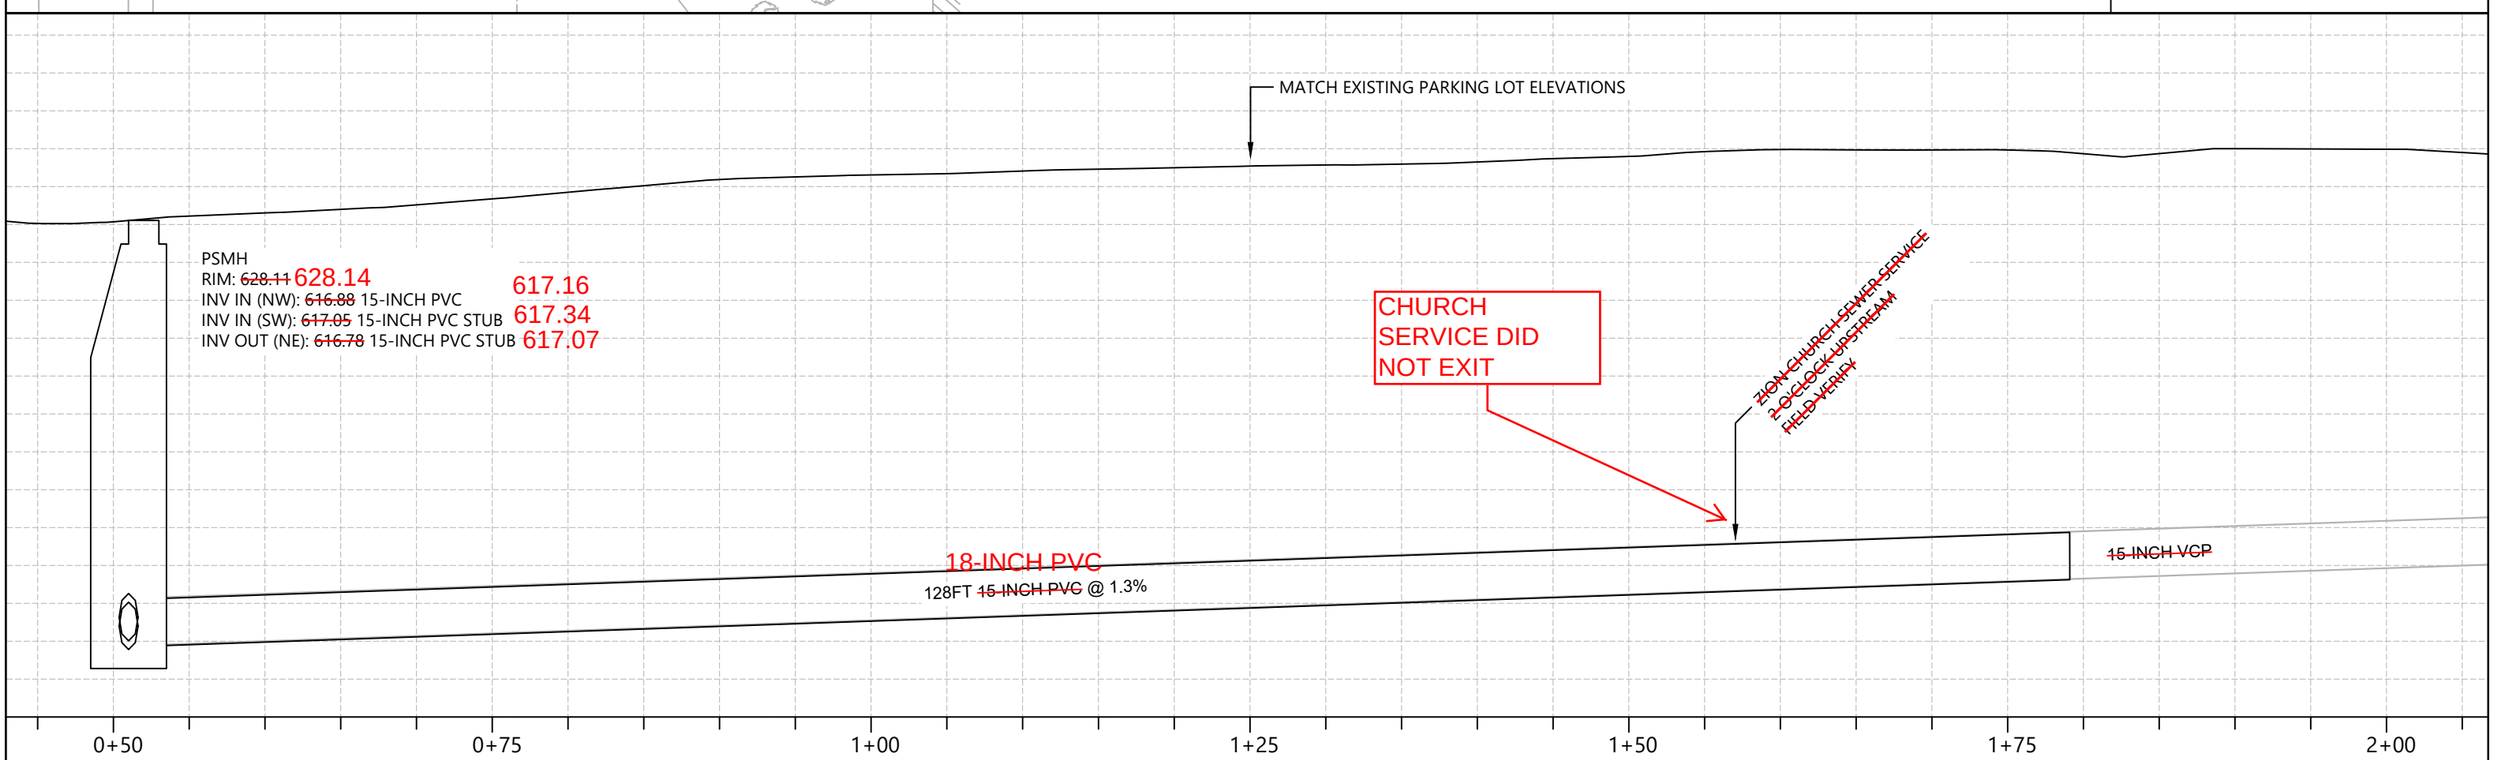

CITY OF SUPERIOR, WI - ENVIRONMENTAL SERVICES DIVISION OF PUBLIC WORKS	PARTIAL REPLACEMENT PLAN & PROFILE	DRAWN: BG	PLOT: 1/4/2023	SHEET 5 OF 6
21ST AVENUE EAST SANITARY BRANCH SEWER PARTIAL REPLACEMENT		APPROVED: EA	0 5 10 FEET	ADDENDUM: (N/A)