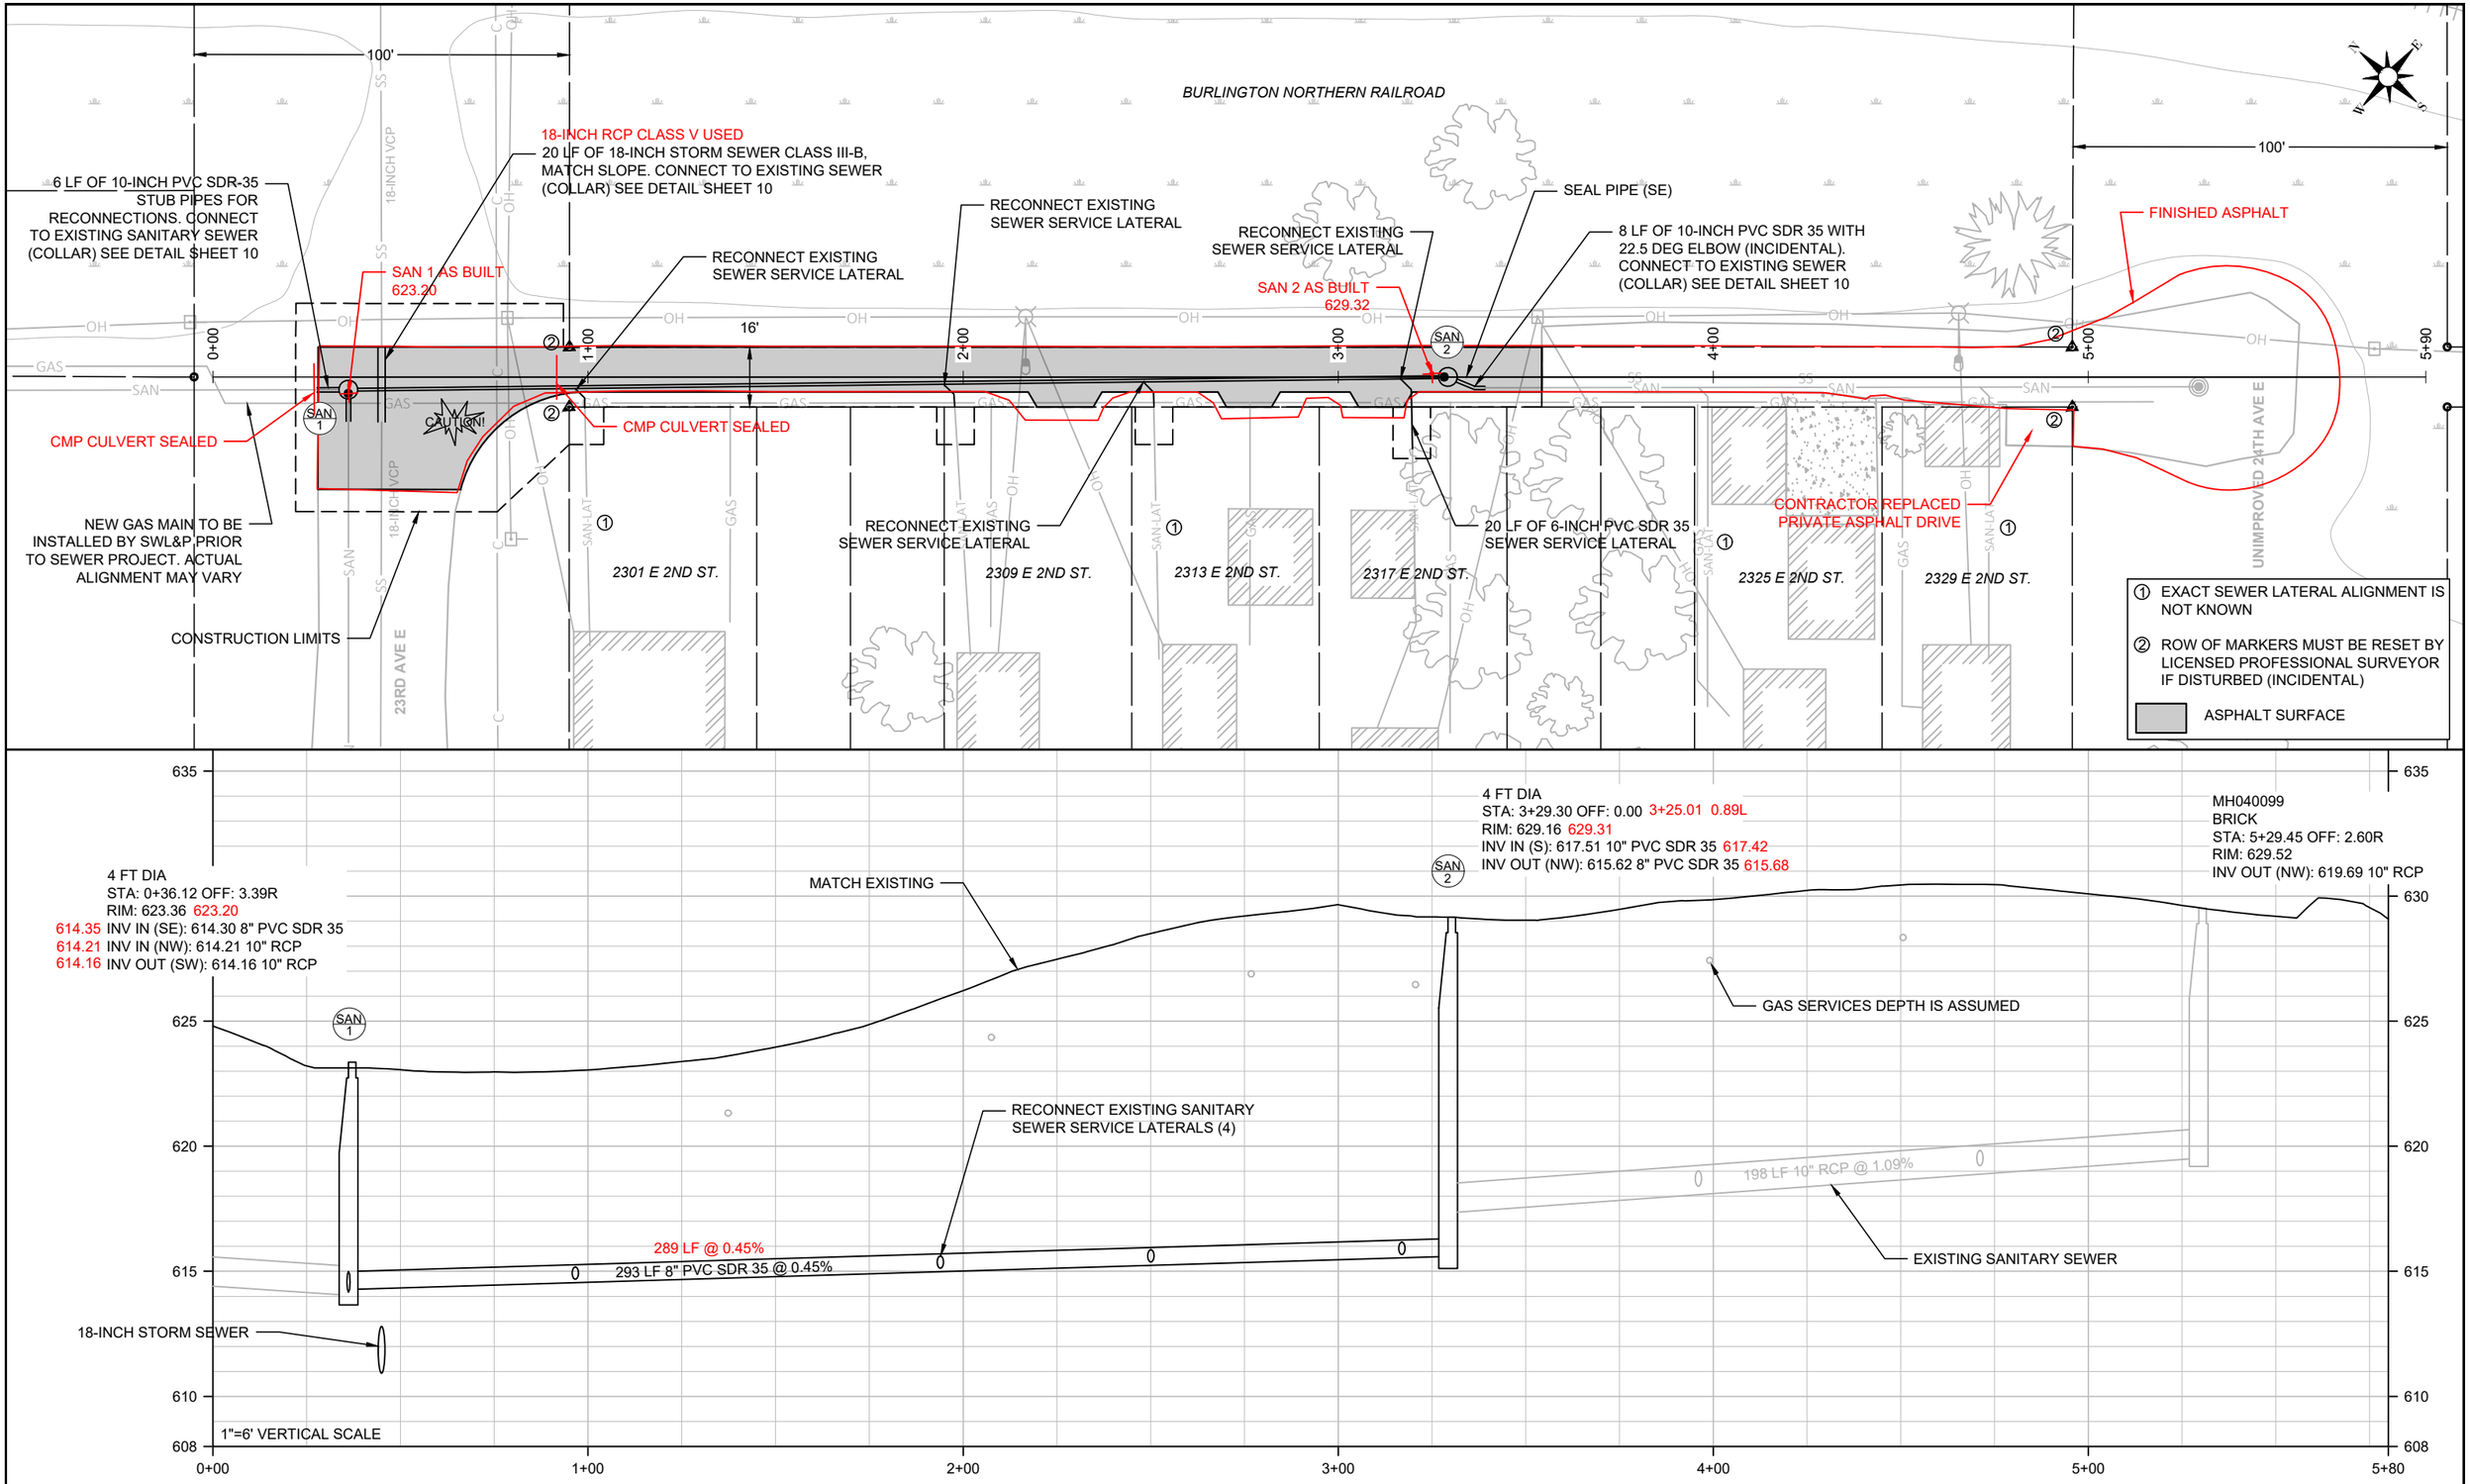

CITY OF SUPERIOR, WI – ENVIRONMENTAL SERVICES DIVISION OF PUBLIC WORKS	PROPOSED PLAN & PROFILE	DRAWN: CC	PLOT: 10/31/2023	SHEET 6 OF 12
23RD AVENUE EAST SANITARY/STORM RECONSTRUCTION		APPROVED: EA	0 20 40 FEET	ADDENDUM: (N/A)