


CITY OF SUPERIOR
 SEWAGE INTERCEPTING SYSTEM
 AUGUST 1936
 PROFILES, SECTION "D"
 SHEET NO 3 OF 5

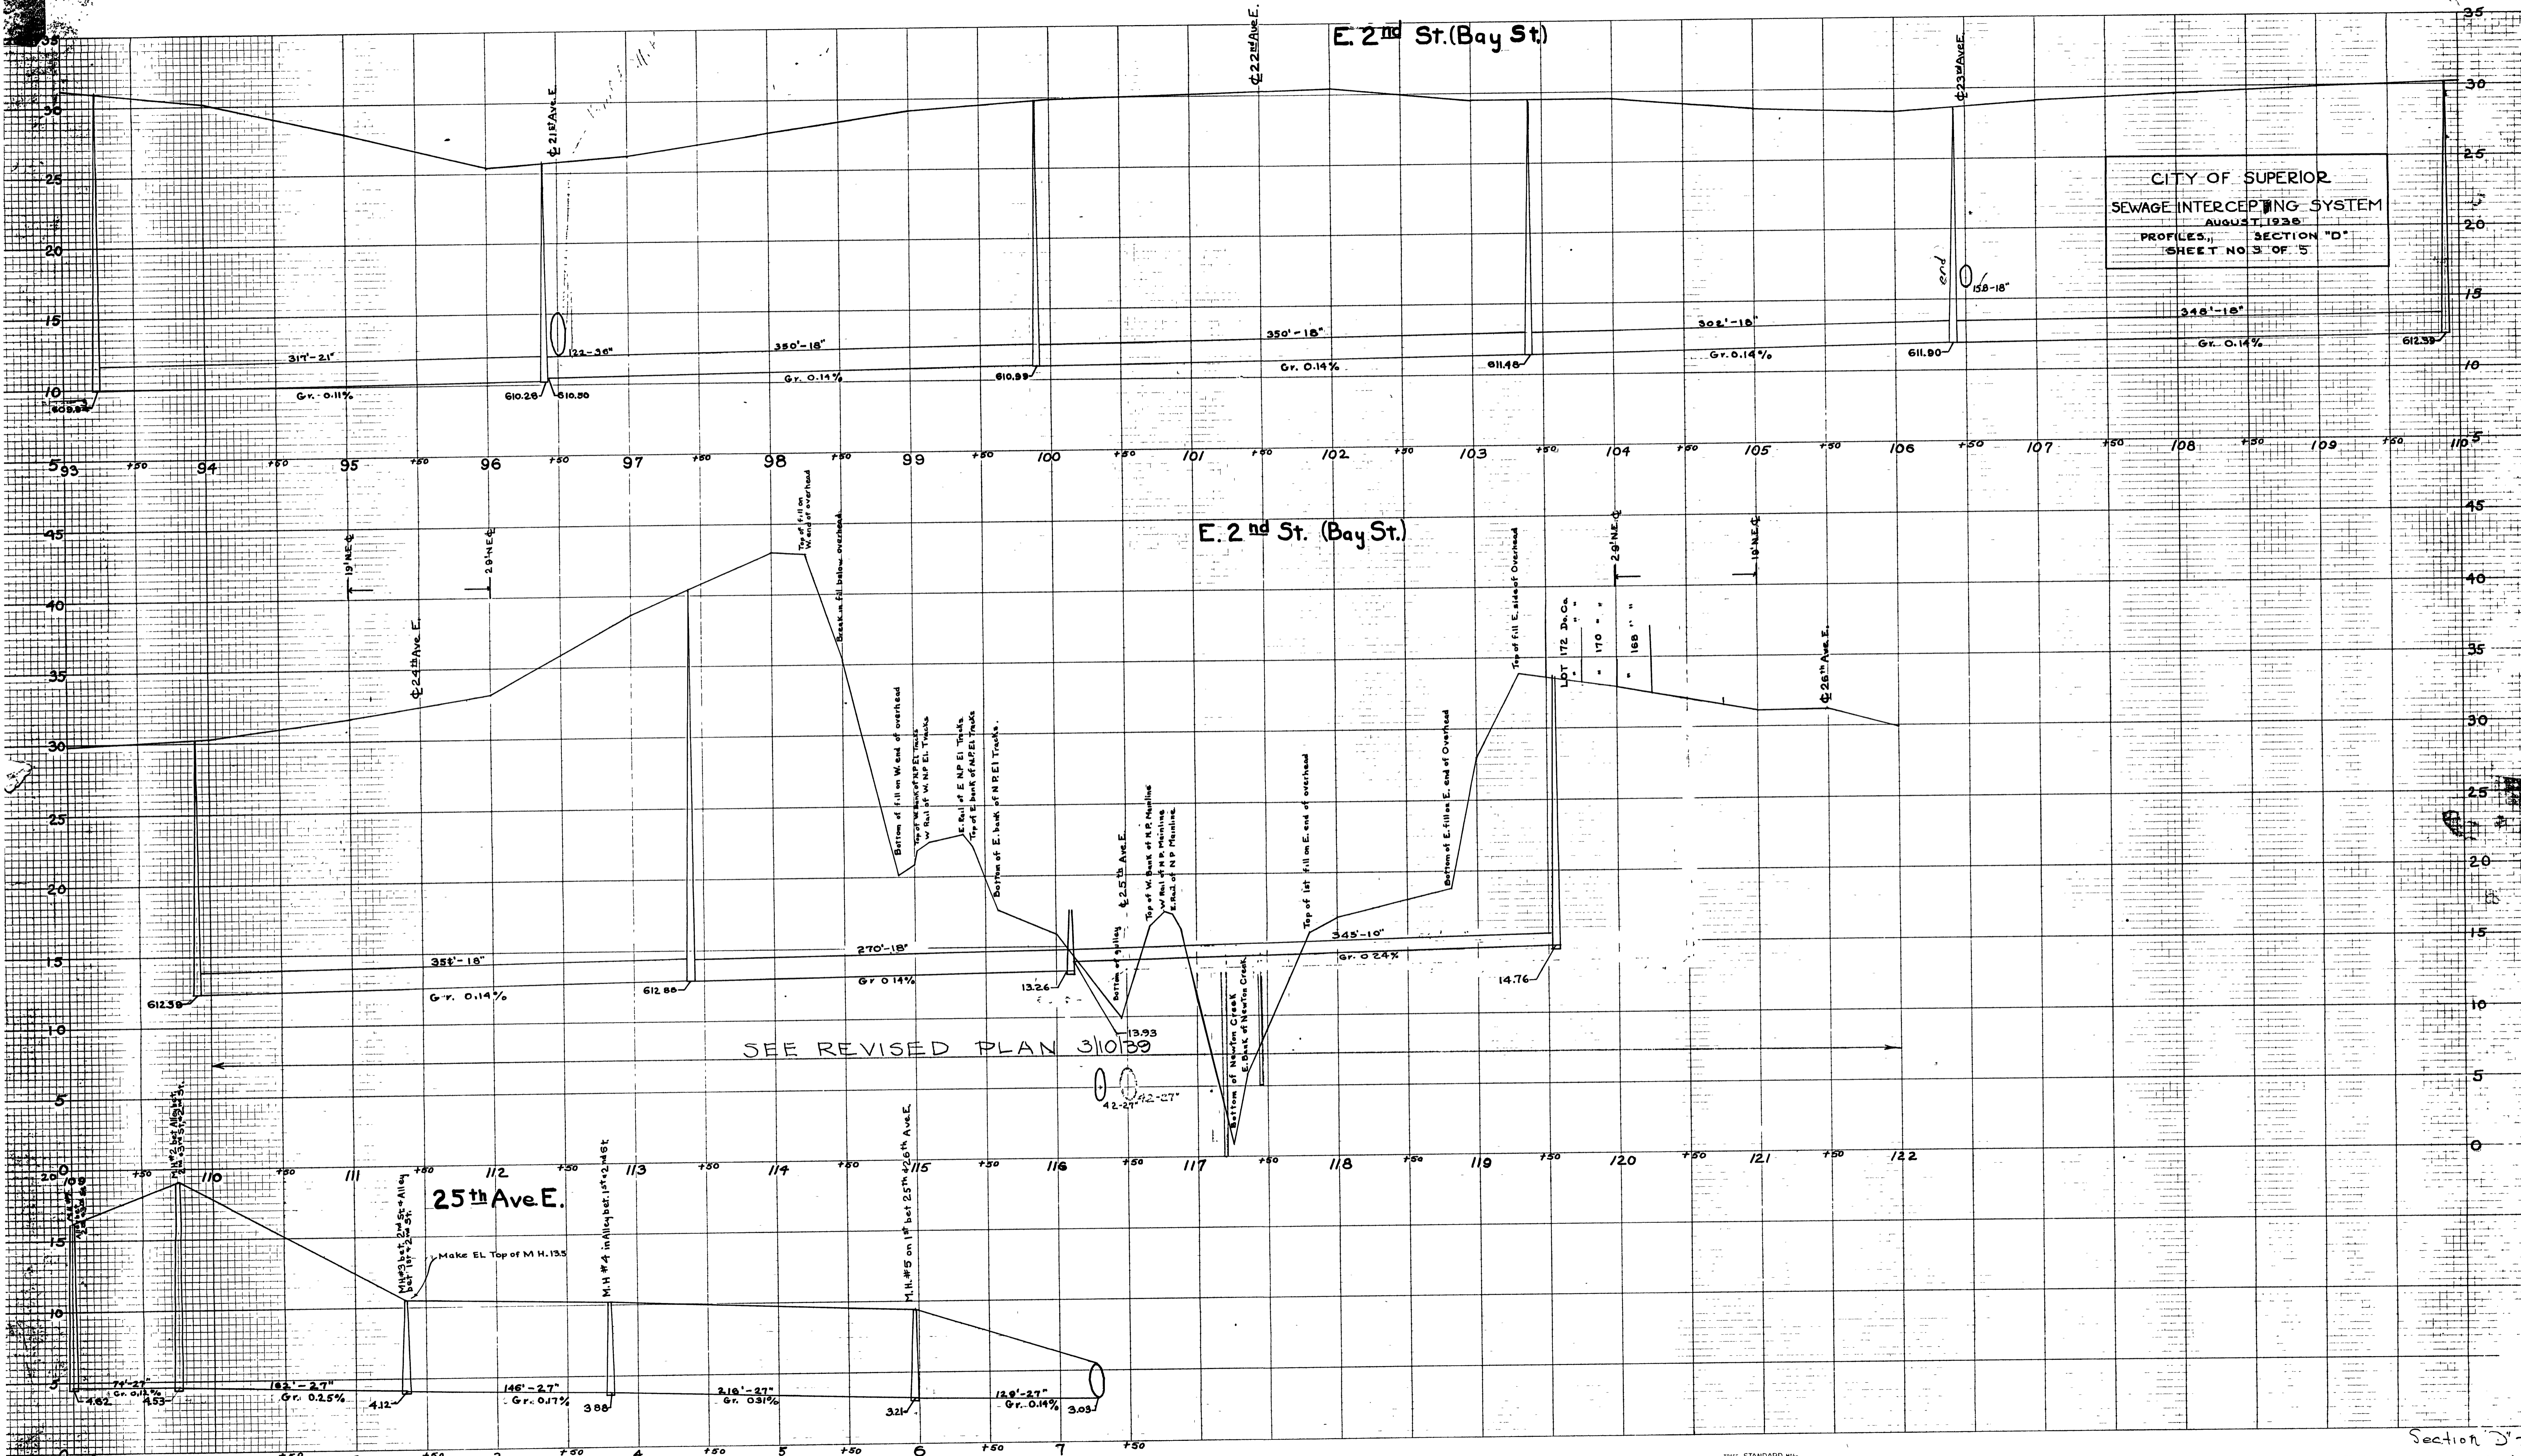

STANDARD MAP
 KEUFFEL & ESSER CO.
 NEW YORK

KEUFFEL & ESSER CO.
 NEW YORK

TIME STANDARD
 KEUFFEL & ESSER CO.
 NEW YORK

KEUFFEL & ESSER CO.
 NEW YORK

Section D-4
 No. 3