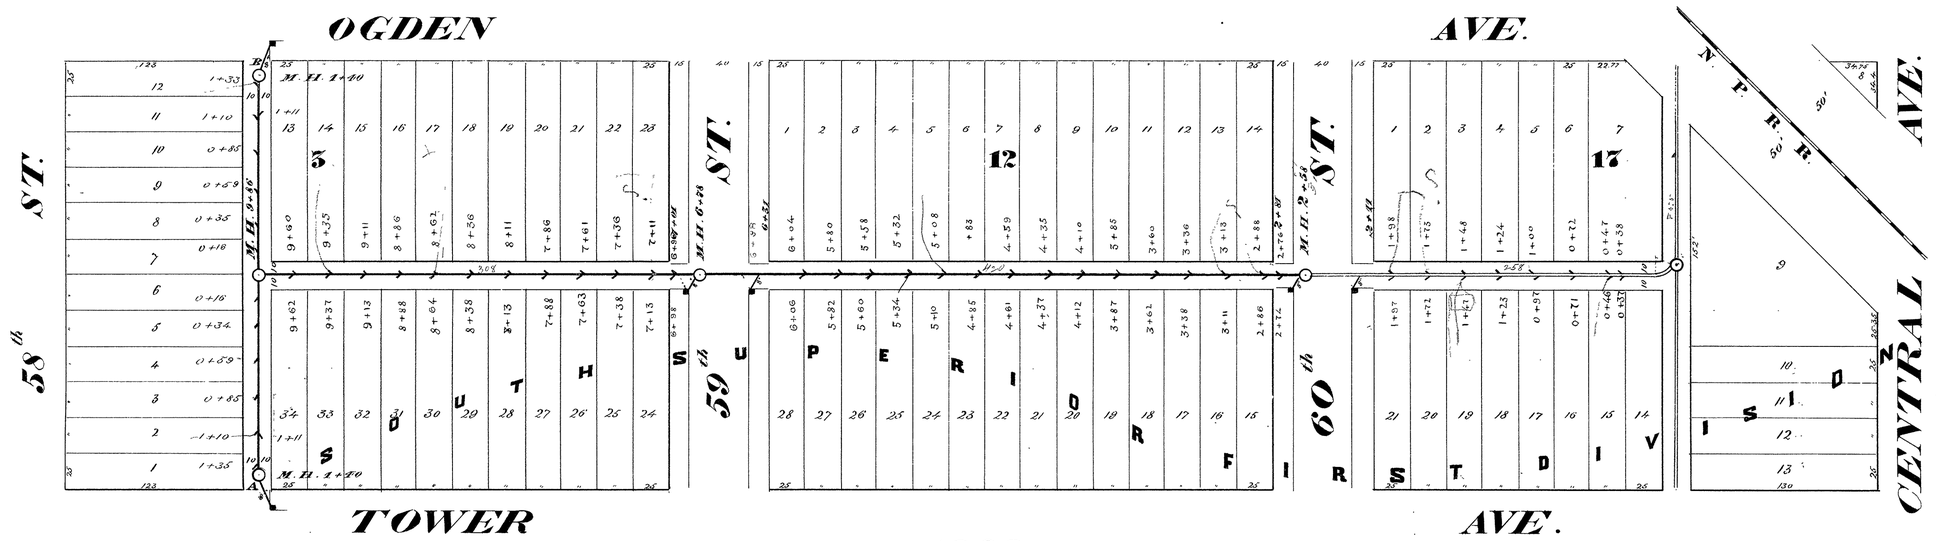

CITY OF SUPERIOR

SEWER PLAN

Contract let Feb. 4. 1892
Completed Sept. 1, 1892
Wolf & King. Contractors
Duff & Lanagan, Inspectors
A. S. Cooper, City Engineer

1893

Section of 10 Pipe

Section of 12 Pipe

Section of 15 Pipe

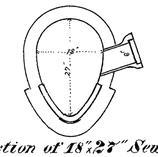

Section of 18"x27" Sewer

Scale: Horizontal 60'= 1"
Vertical 4' = 1"
Section 2' = 1"

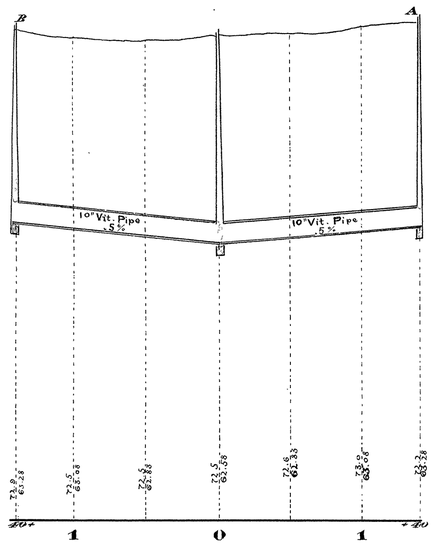

Profile of Sewer from A to B

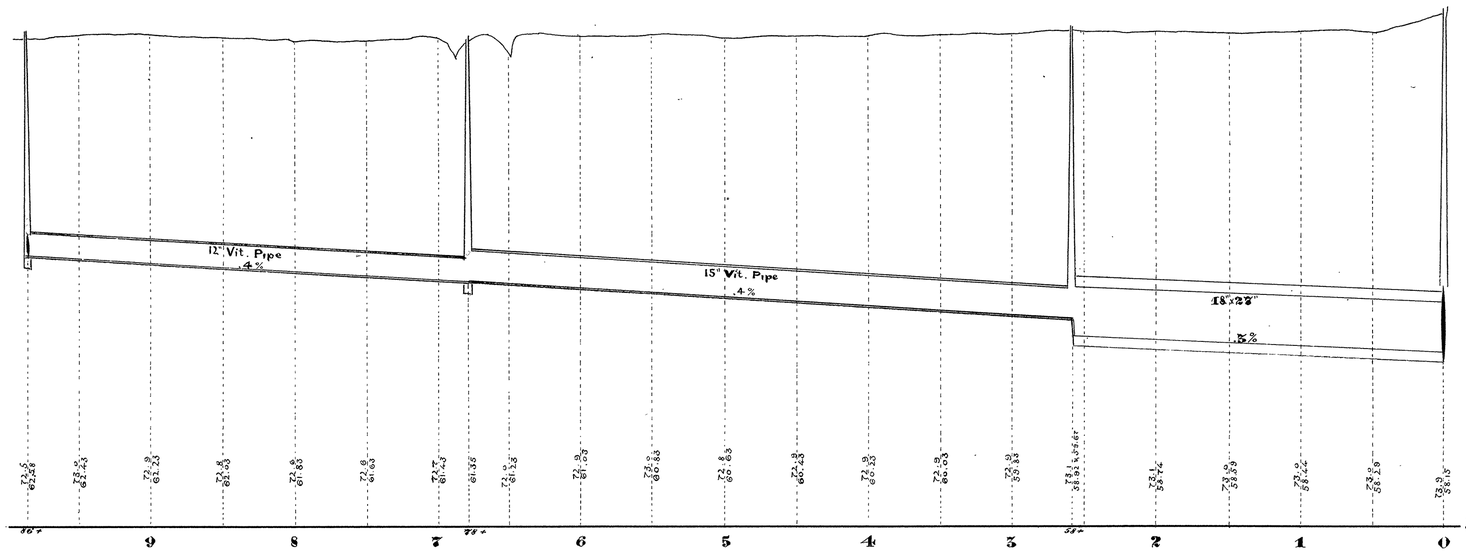

Plan & Profile of Sewer in Alley betw. Ogden and Tower Aves. from Central Ave. to Fifty-eighth St. and Lateral

5-13