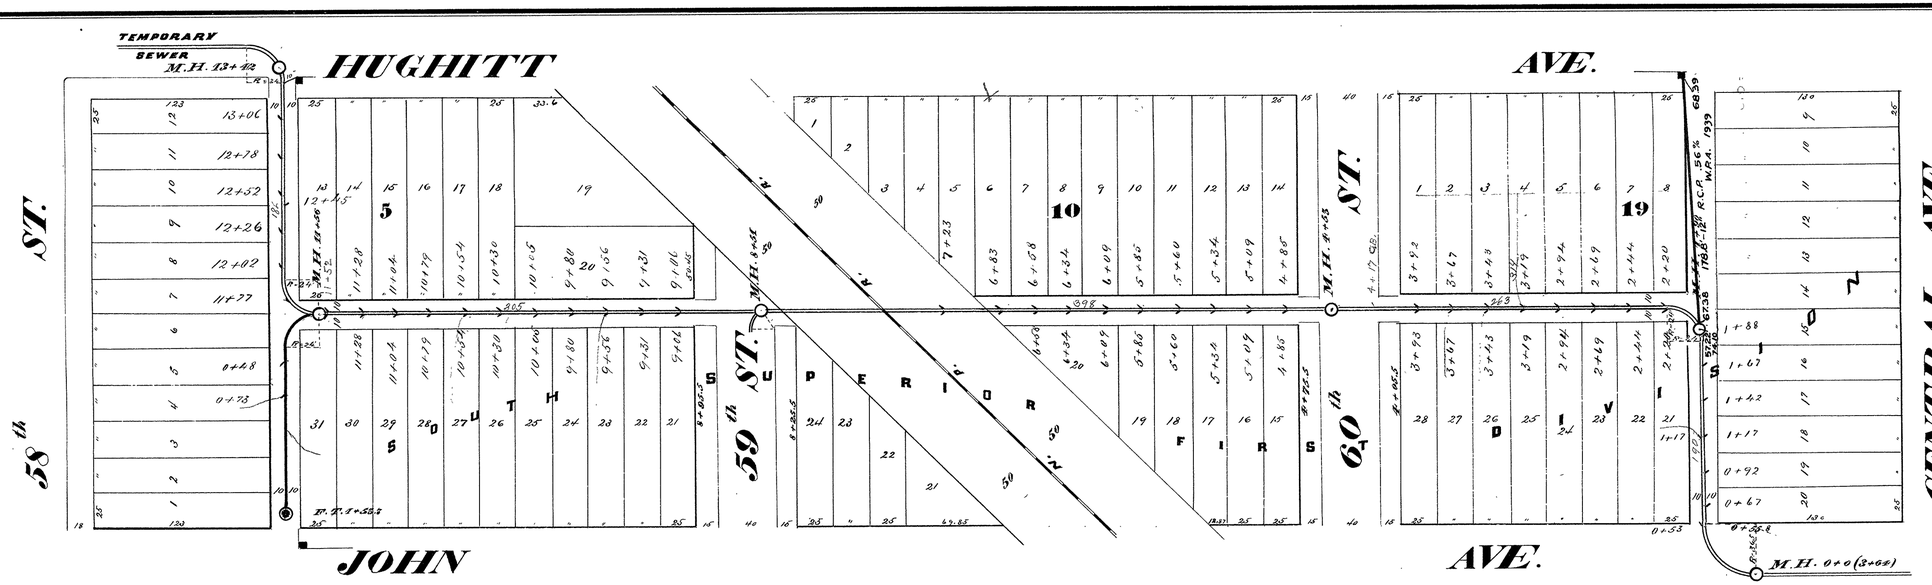

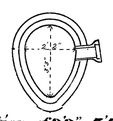

Section of 22"x33" Sewer

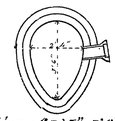

Section of 24"x36" Sewer

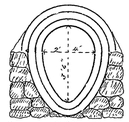

Section of Sewer under Ry.

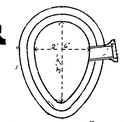

Section of 26"x39" Sewer

1893
CITY OF SUPERIOR
SEWER PLAN

Contract let. May, 23. 1892
completed Oct. 1, 1892
Wolf & King, Contractor
John Dailey, Inspector
A. S. Cooper, City Engineer

Scale: Horizontal 1" = 60'
Vertical 1" = 4'
Section 1" = 4'

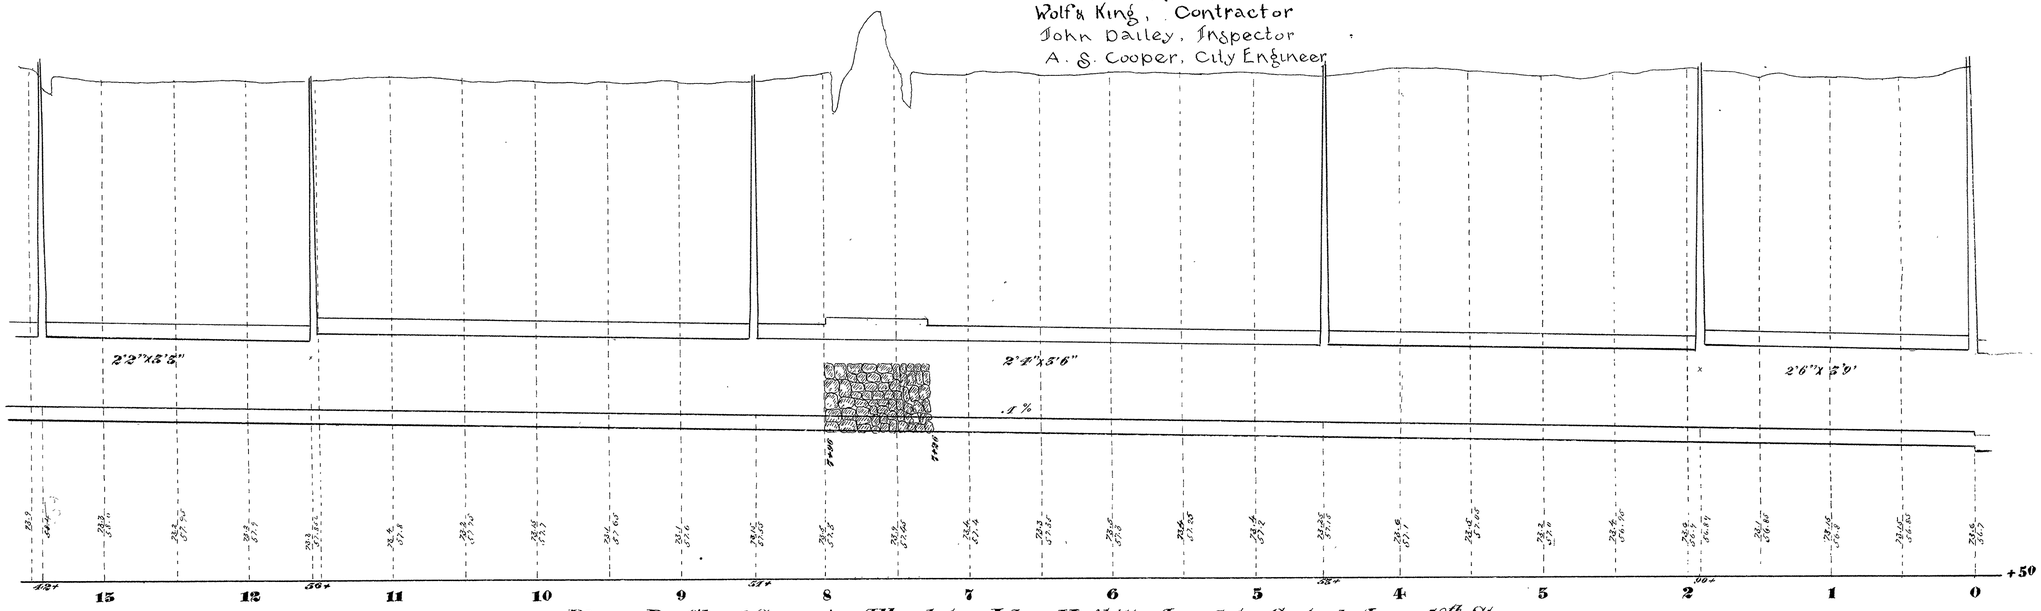

Plan & Profile of Sewer in Alley betw. John & Hughitt Aves. betw. Central Ave. & 58th St.

5-15