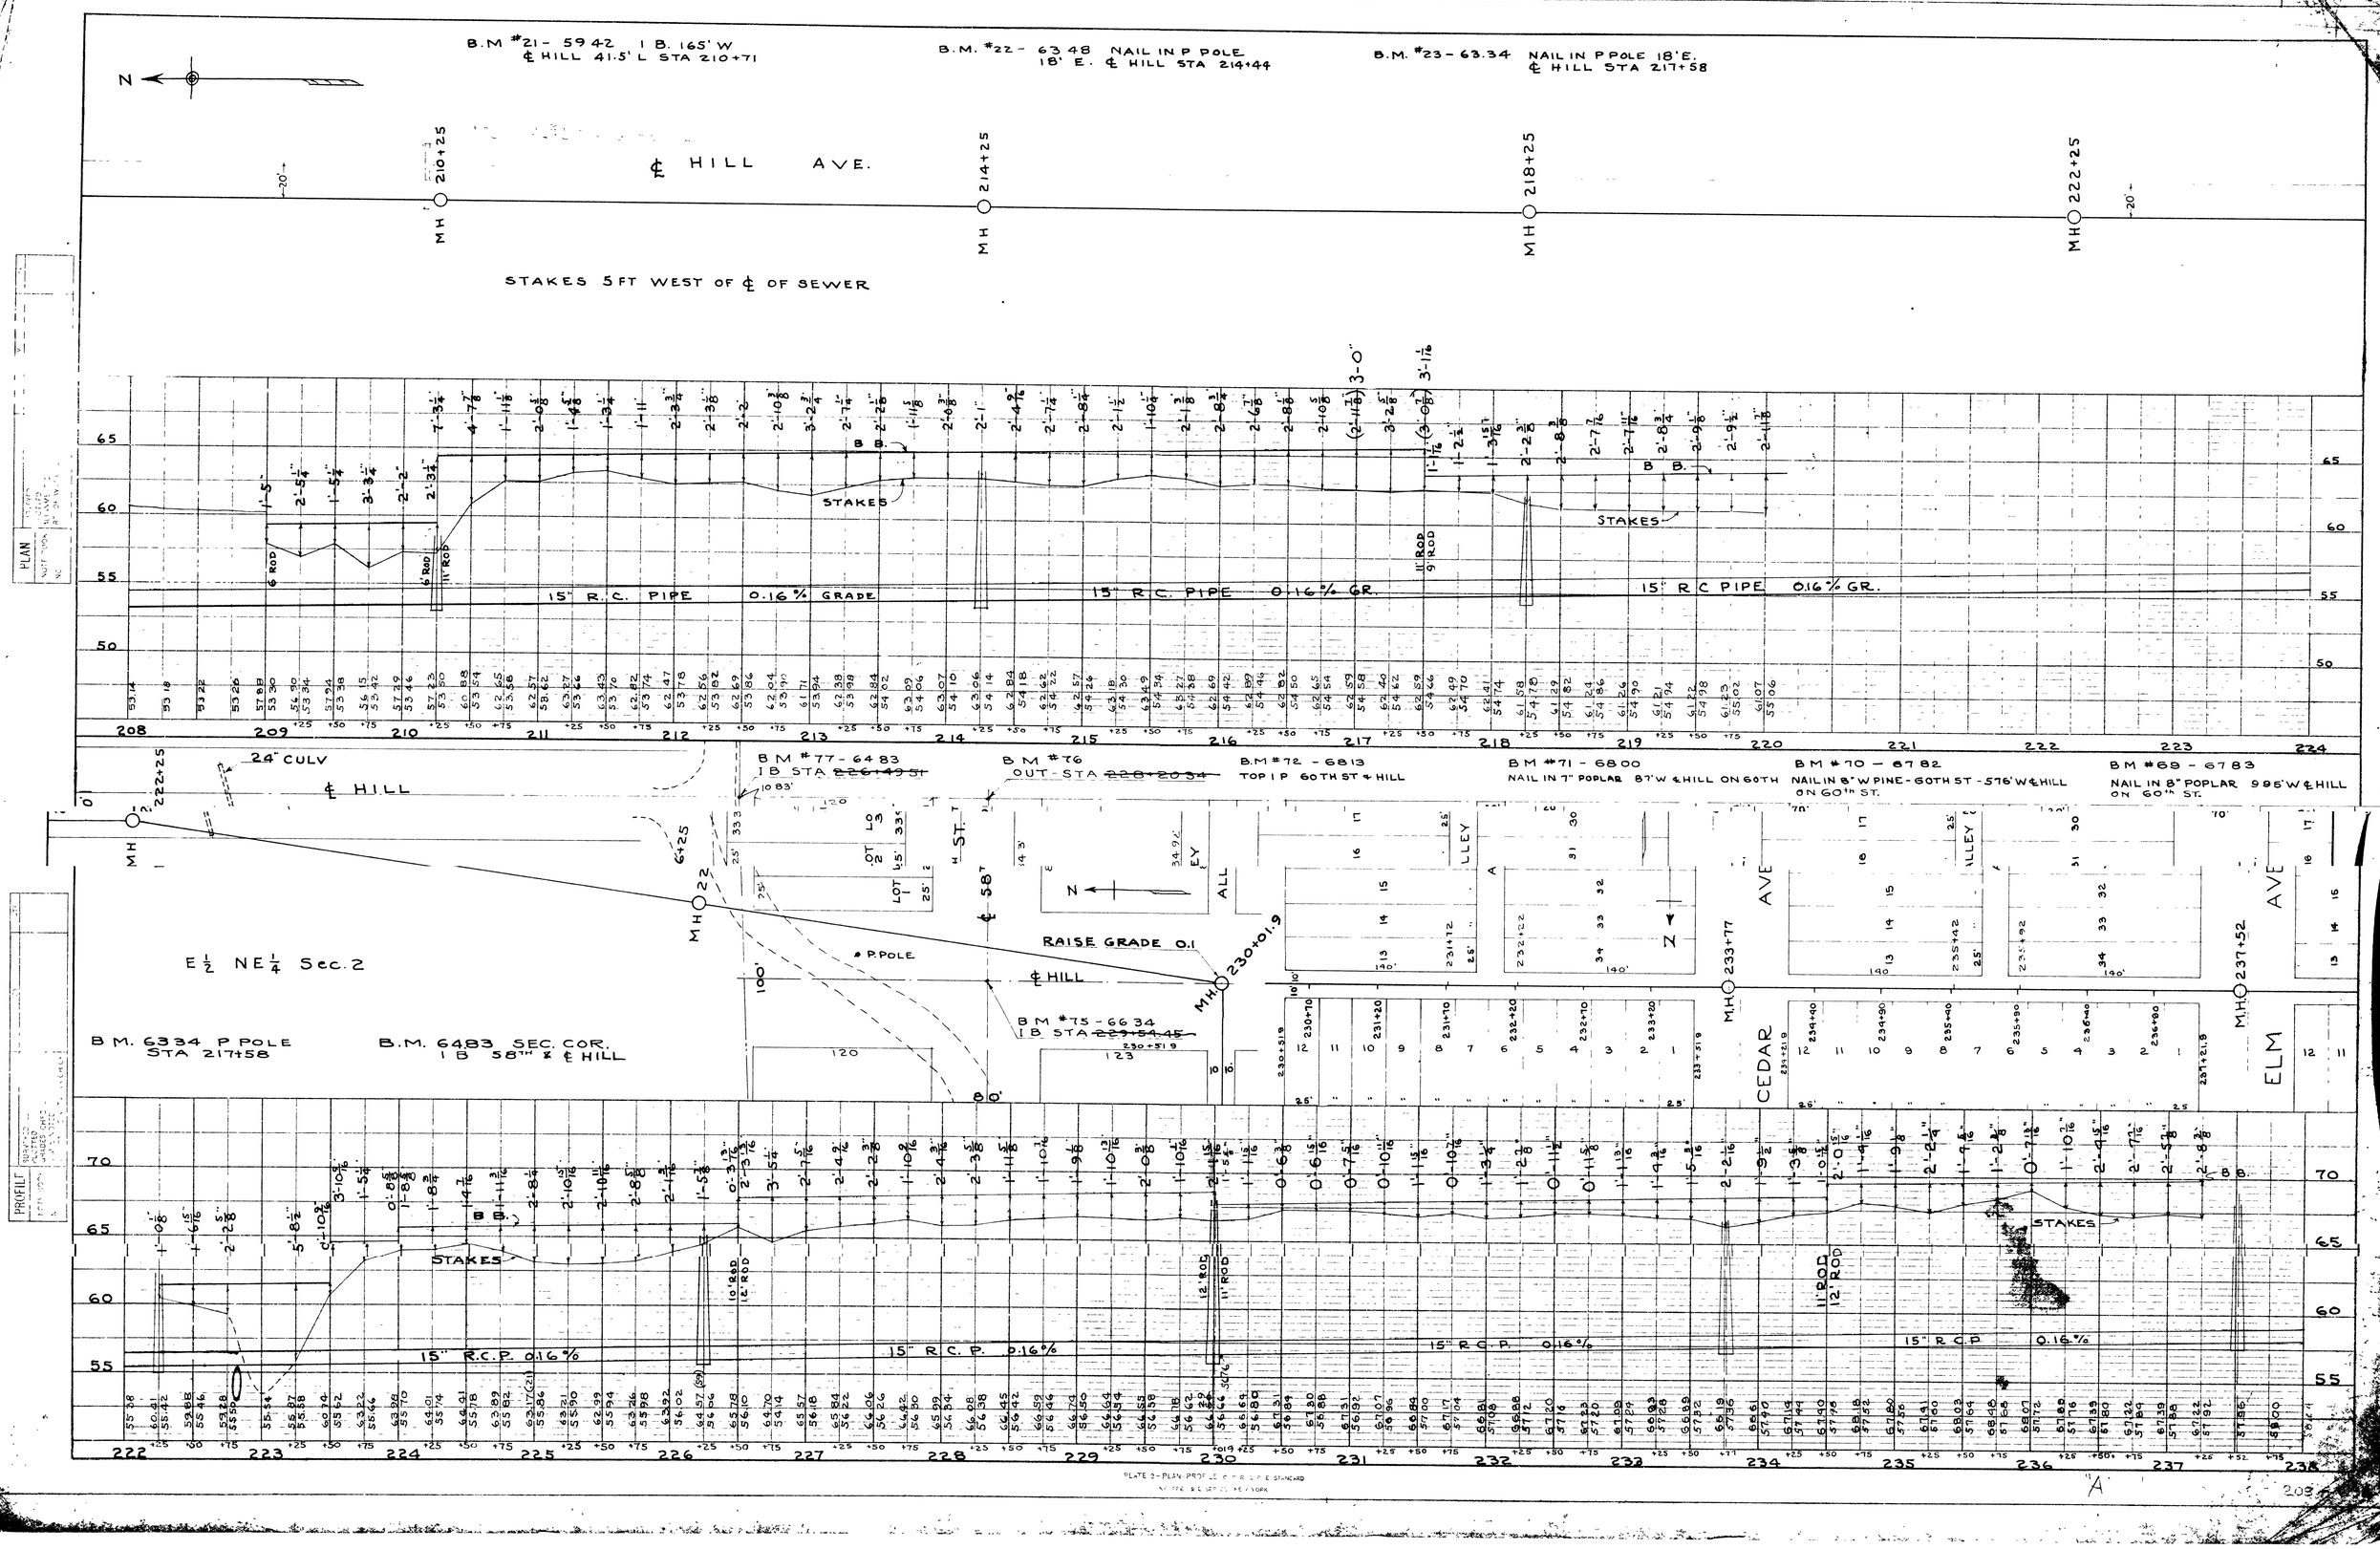

B.M #21 - 59.42 I B. 165' W ℄ HILL 41.5' L STA 210+71
B.M. #22 - 63.48 NAIL IN P POLE 18' E. ℄ HILL STA 214+44
B.M. #23 - 63.34 NAIL IN P POLE 18' E. ℄ HILL STA 217+58
℄ HILL AVE.
MH 210+25
MH 214+25
MH 218+25
MH 222+25
STAKES 5 FT WEST OF ℄ OF SEWER
15" R.C. PIPE 0.16% GRADE
15" R.C. PIPE 0.16% GR.
15" R.C. PIPE 0.16% GR.
STAKES
B.B.
24" CULV
℄ HILL
B.M #77 - 64.83 I B STA 226+49.51
B.M #76 OUT - STA 228+20.34
B.M #72 - 68.13 TOP I P 60TH ST & HILL
B.M #71 - 68.00 NAIL IN 7" POPLAR 87' W & HILL ON 60TH
B.M #70 - 67.82 NAIL IN 8" W PINE - 60TH ST - 576' W & HILL ON 60th ST.
B.M #69 - 67.83 NAIL IN 8" POPLAR 995' W & HILL ON 60th ST.
E ½ NE ¼ Sec. 2
B.M. 63.34 P POLE STA 217+58
B.M. 64.83 SEC. COR. I B 58TH & ℄ HILL
RAISE GRADE 0.1
℄ HILL
B.M #75 - 66.34 I B STA 229+54.45
MH 230+01.9
MH 233+77
MH 237+52
CEDAR AVE
ELM AVE
15" R.C.P. 0.16%
15" R.C.P. 0.16%
15" R.C.P. 0.16%
15" R.C.P. 0.16%
STAKES
B.B.
PLAN
PROFILE

A-8