All manholes (MH$_S$) will be of this format

ST Ø5 ØØØ1
Storm MH — District — MH number

CB Ø5 ØØØ1
Catch basin
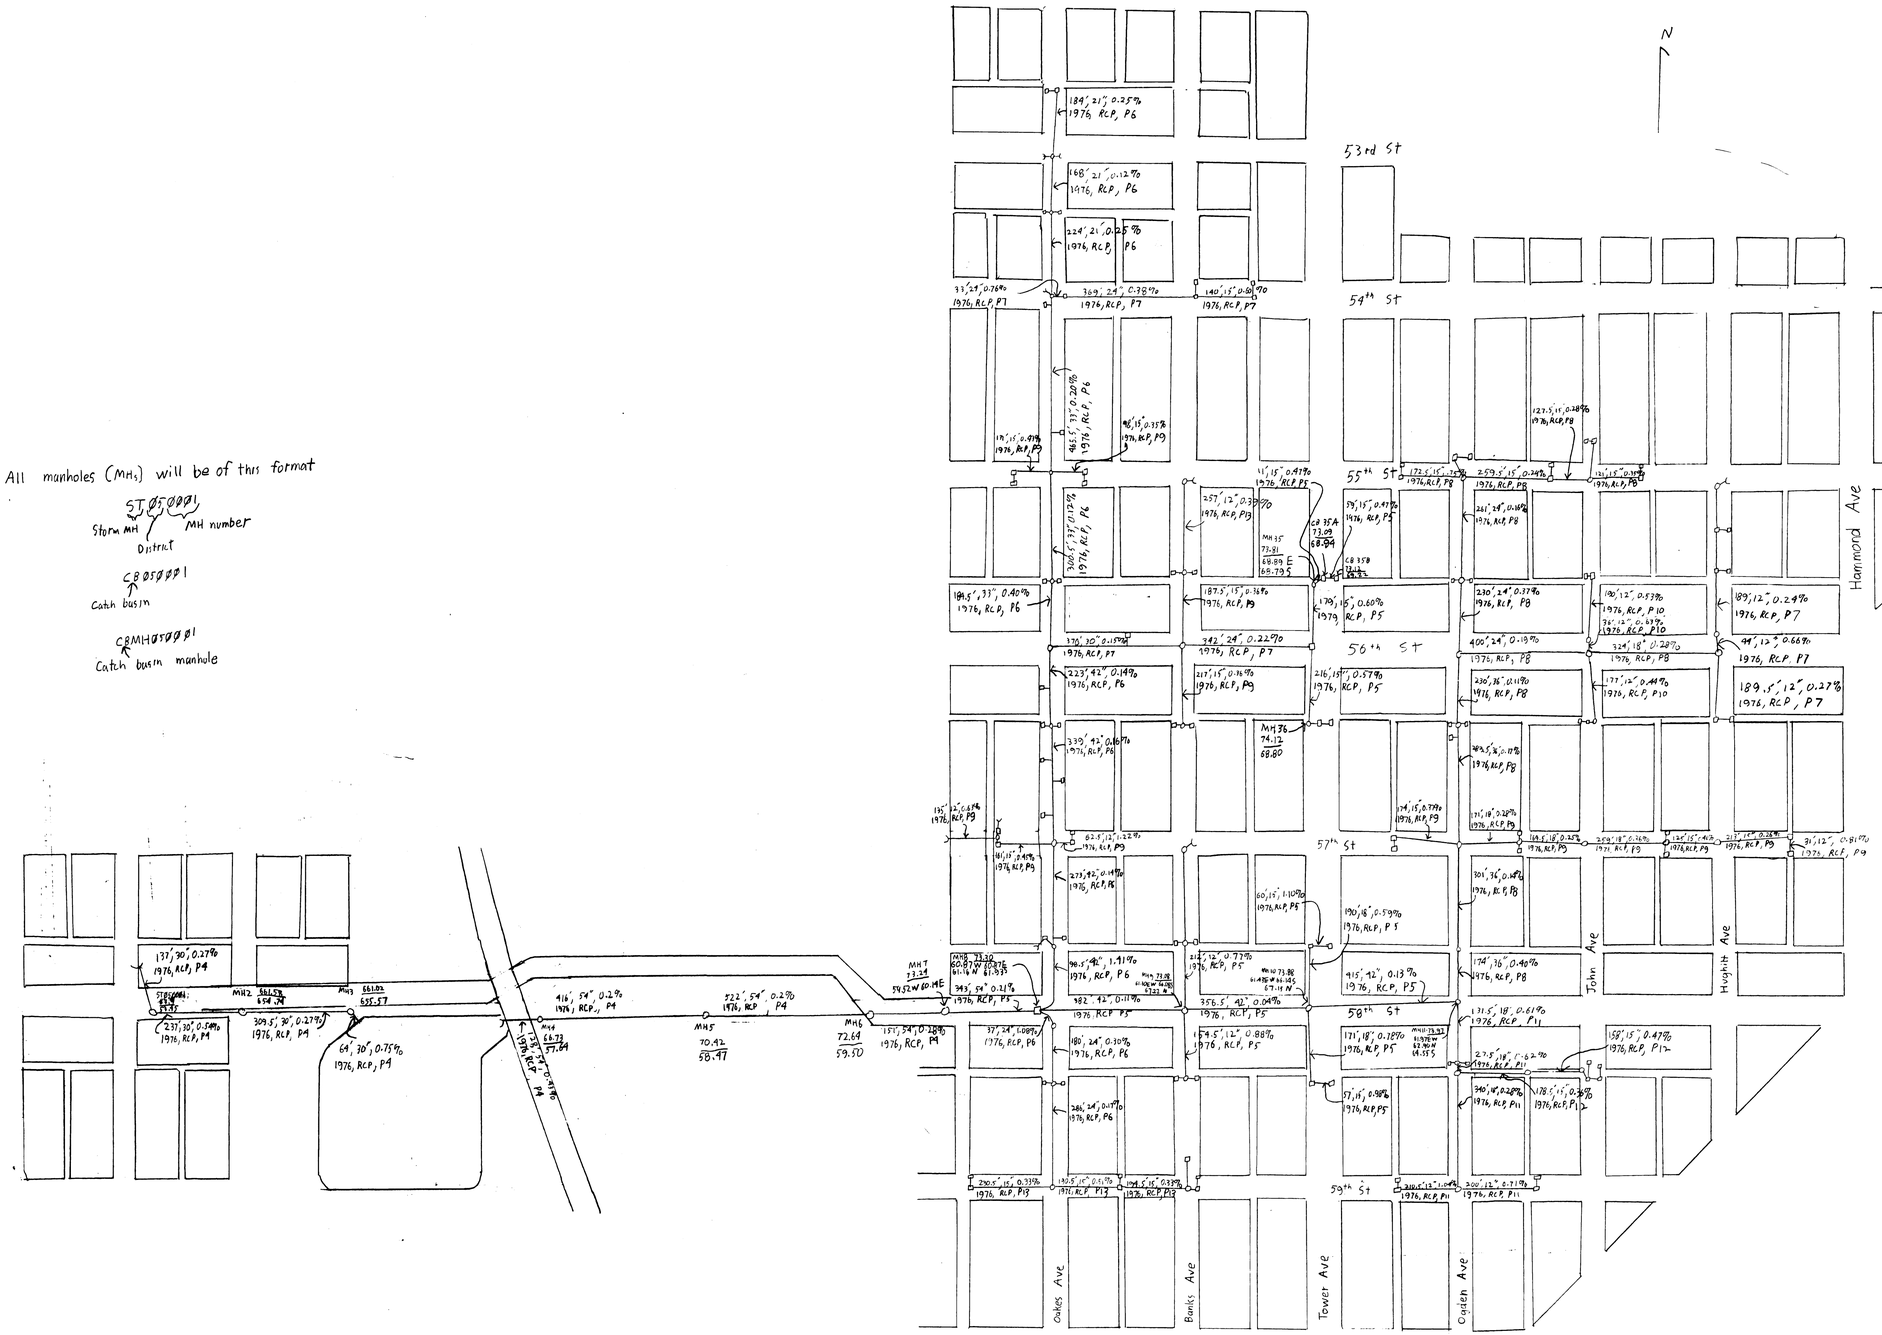
CBMH Ø5 ØØØ1
Catch basin manhole