


PLAN SCALE: 1" = 50' HOR.
1" = 2' VERT.

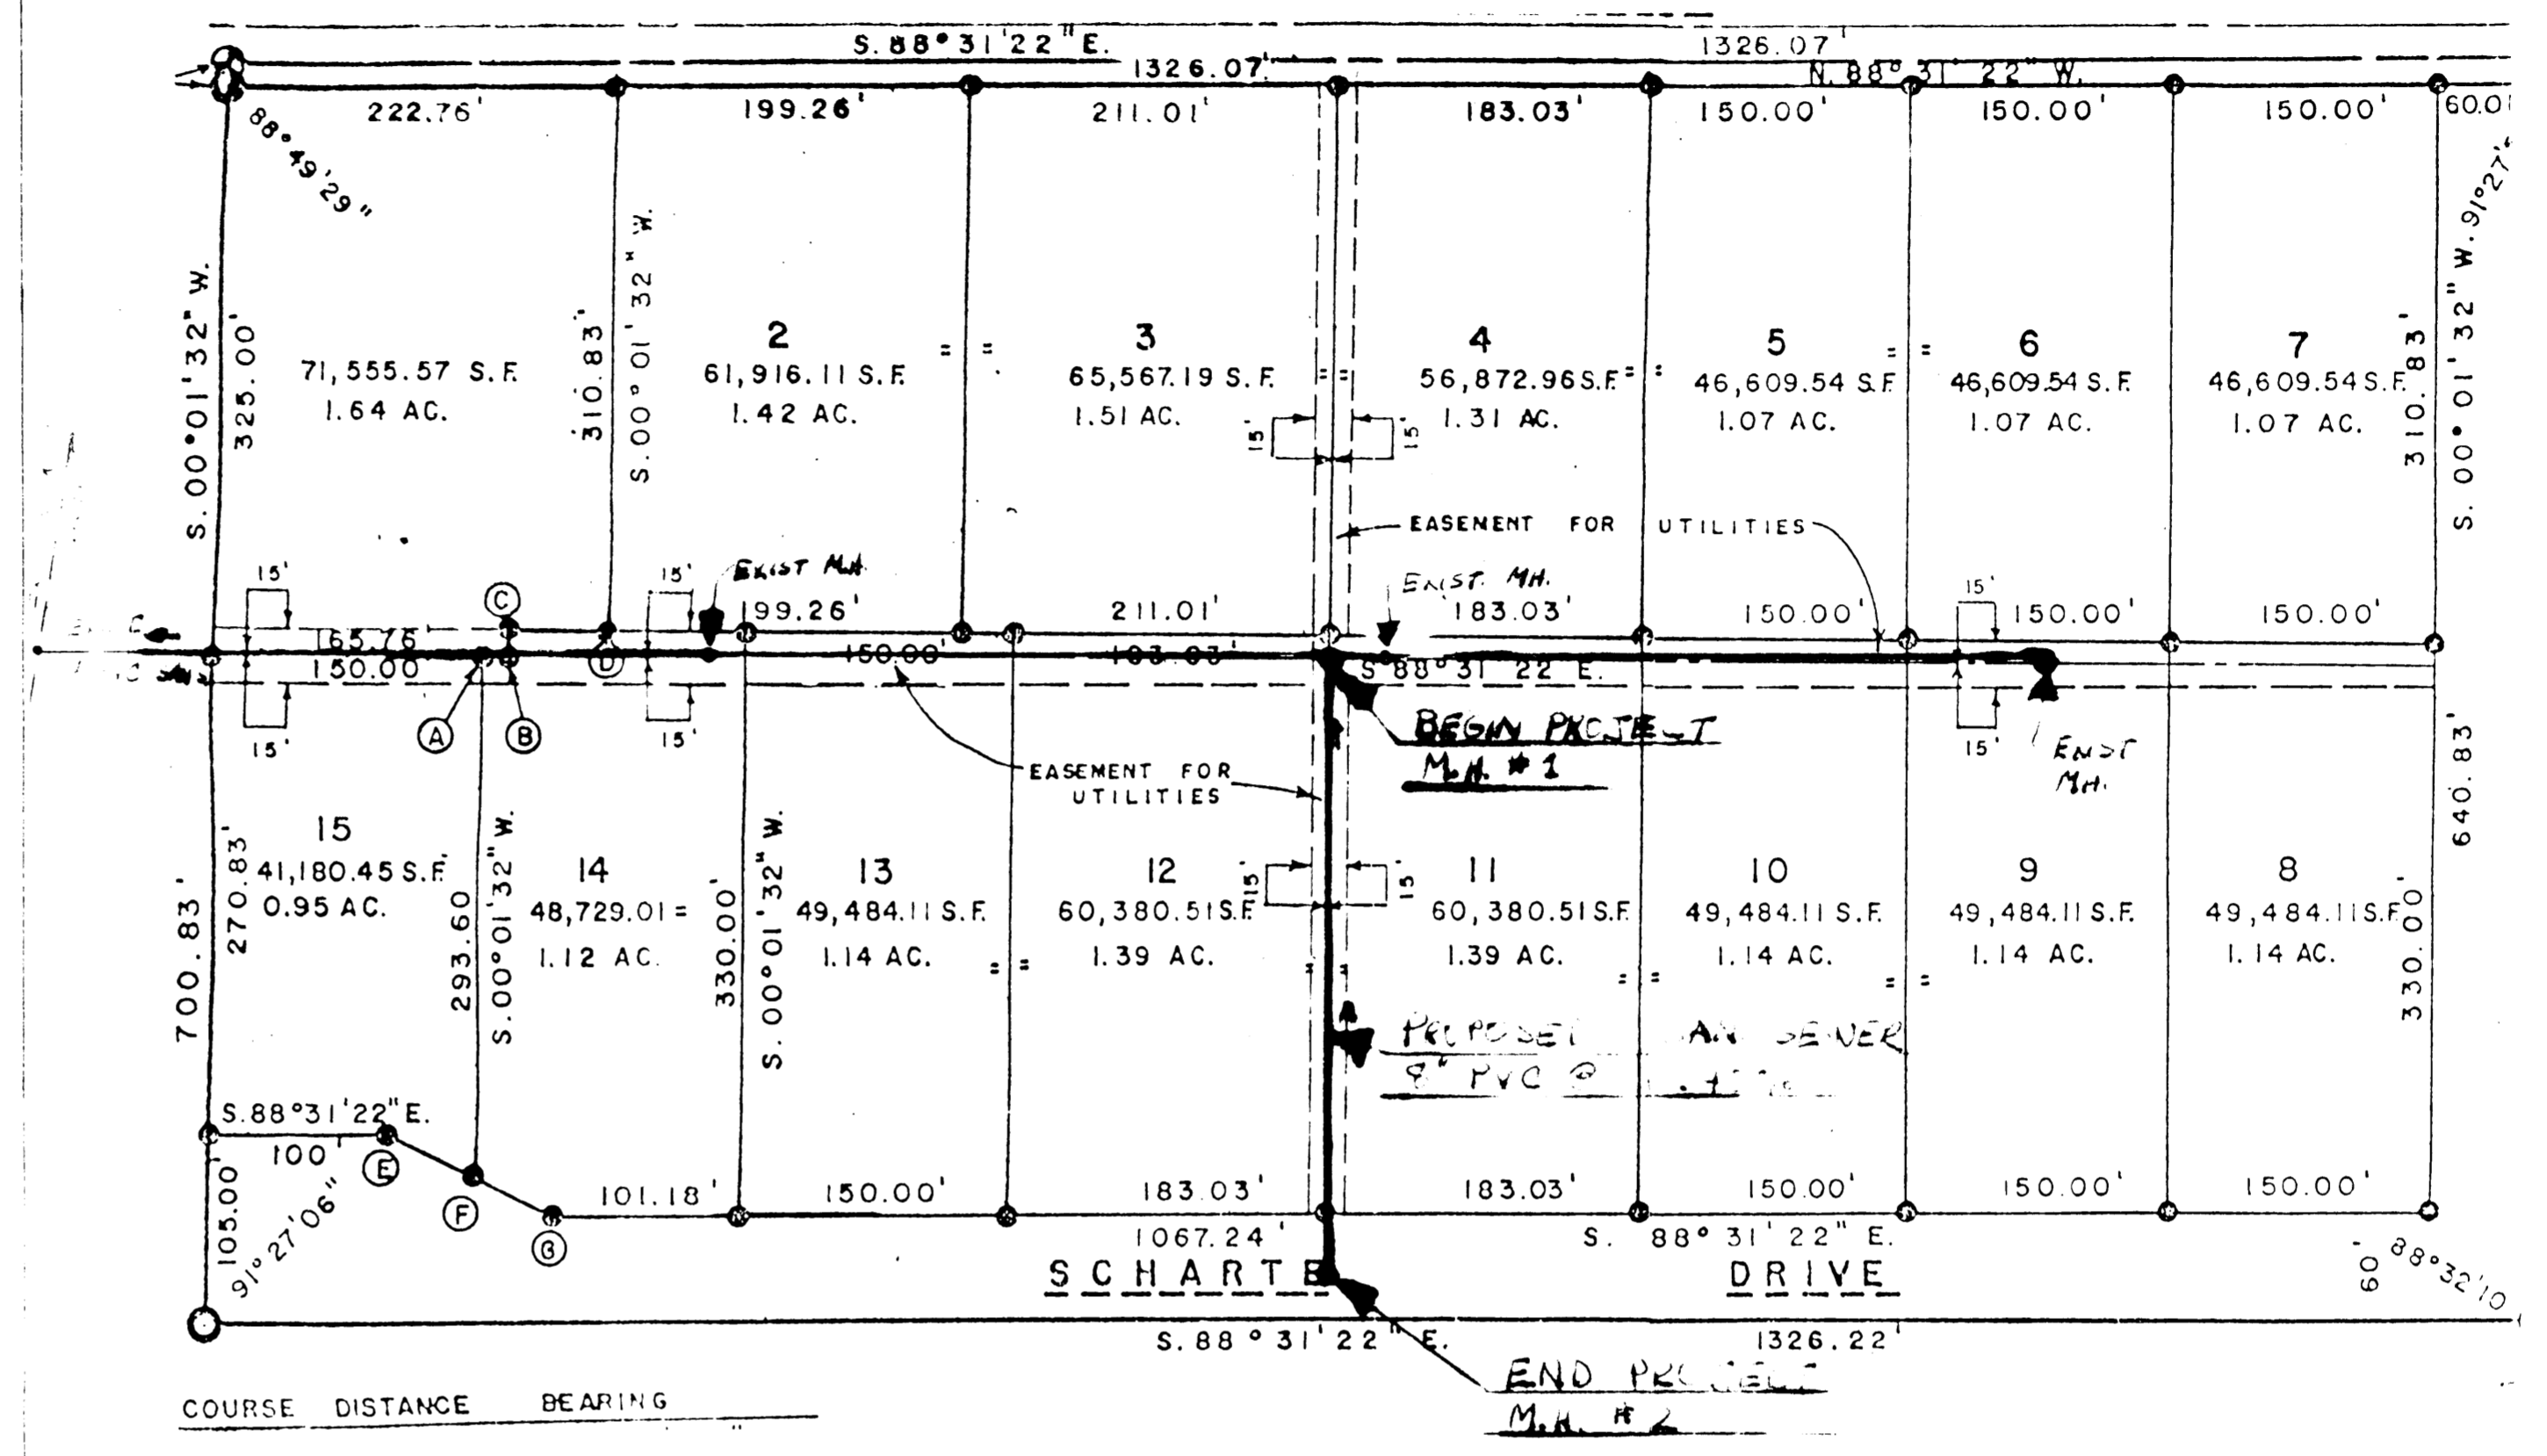

SITE PLAN

