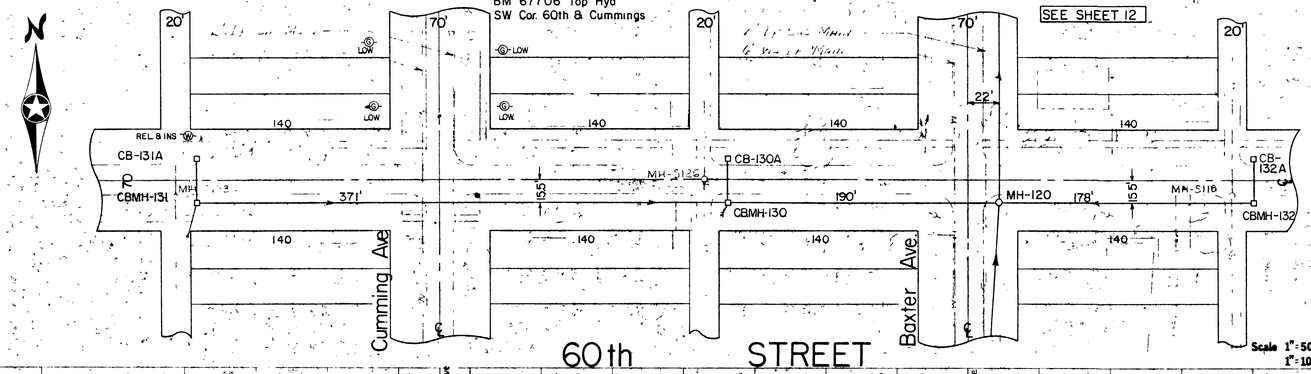

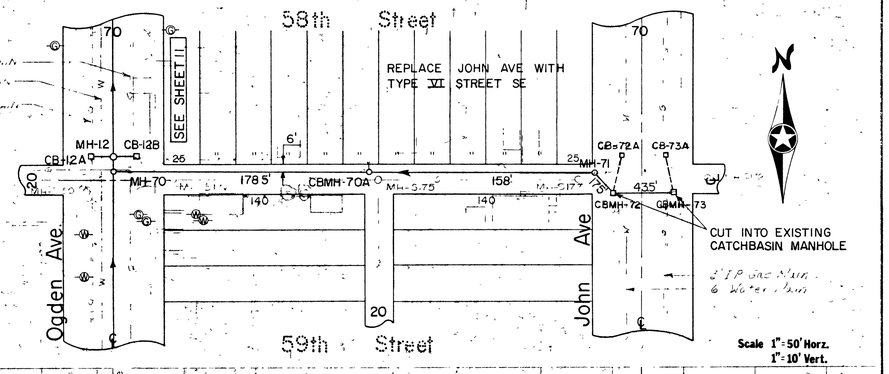

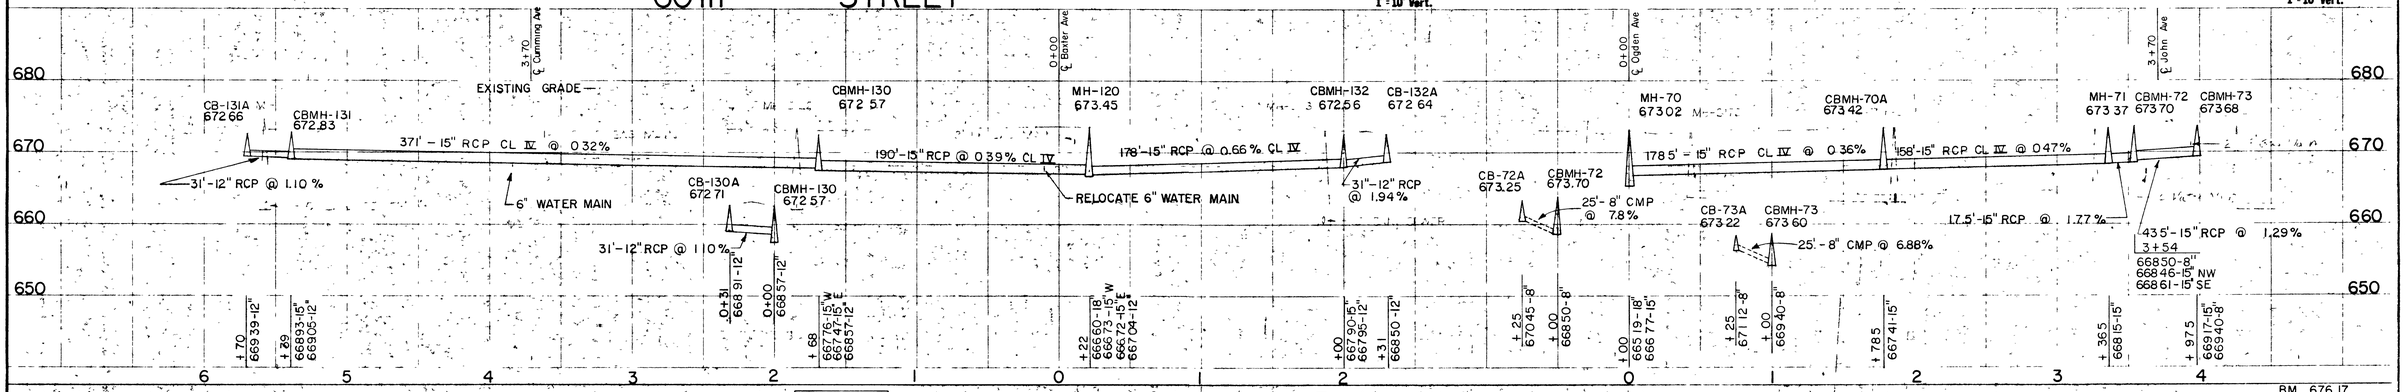

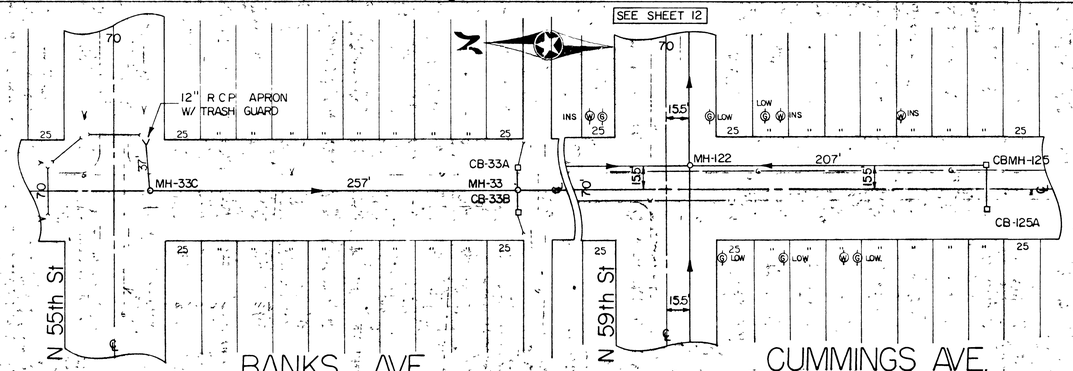

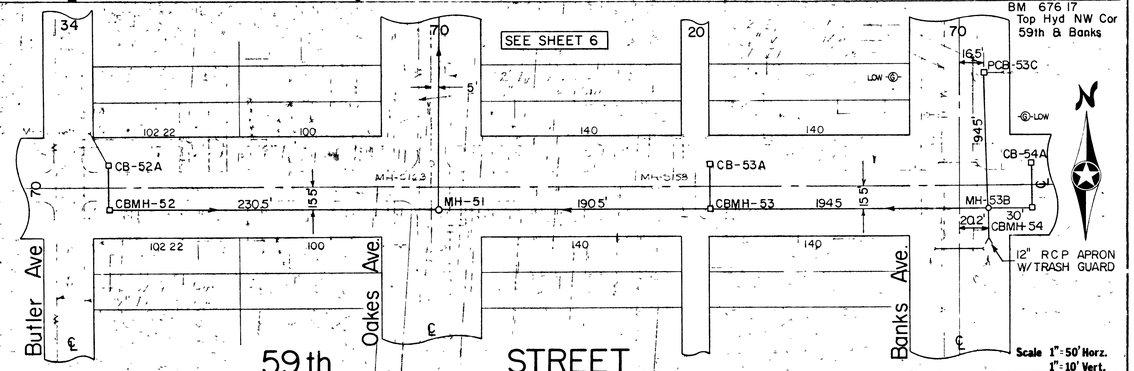

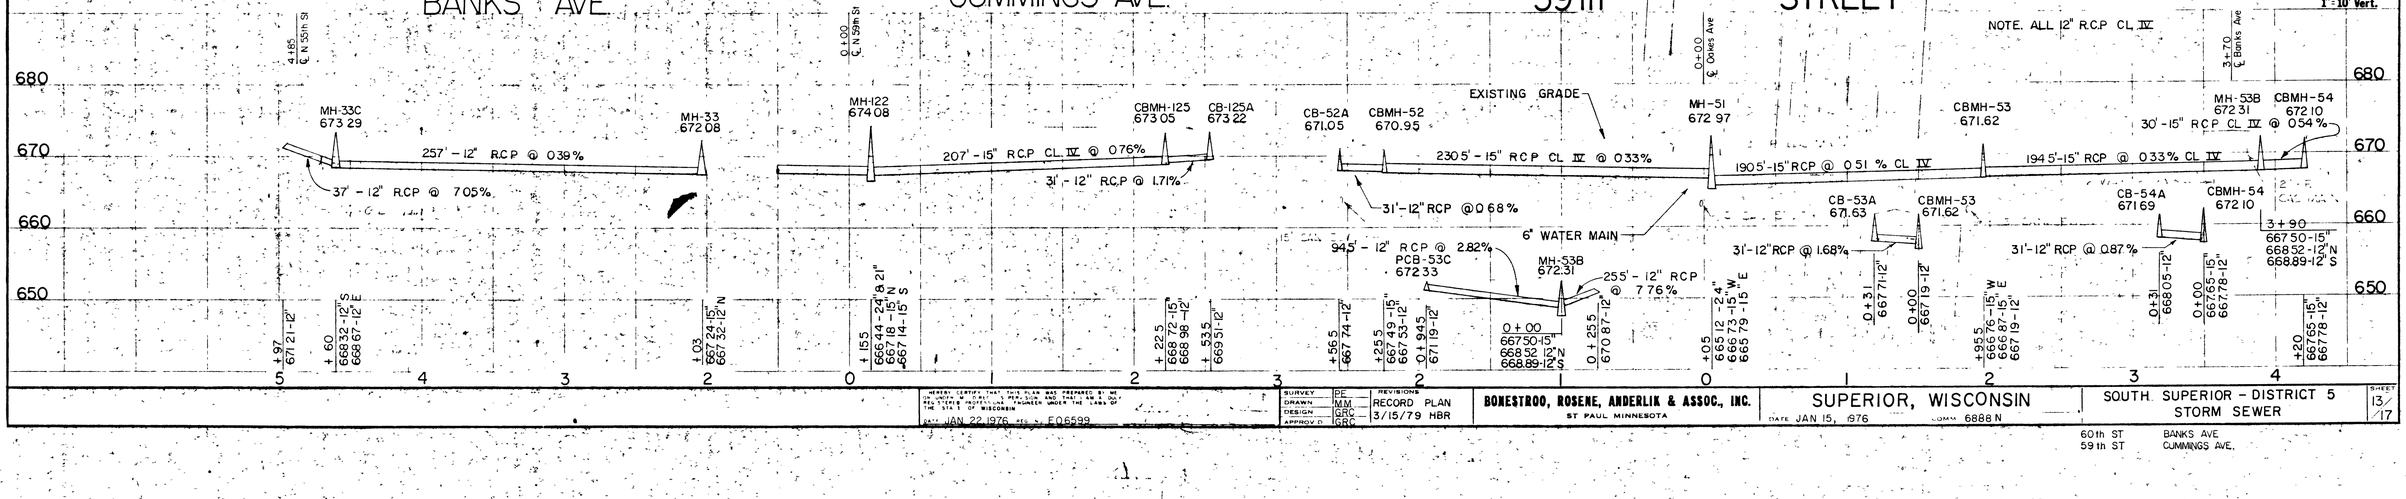

HEREBY CERTIFY THAT THIS PLAN WAS PREPARED BY ME OR UNDER MY DIRECT SUPERVISION AND THAT I AM A DULY REGISTERED PROFESSIONAL ENGINEER UNDER THE LAWS OF THE STATE OF WISCONSIN

DATE JAN 22, 1976 REG. NO. E06599

REVISIONS	
SURVEY PE	
DRAWN MM	RECORD PLAN
DESIGN GRC	3/15/79 HBR
APPROV'D GRC	

BONESTROO, ROSENE, ANDERLIK & ASSOC., INC.
ST PAUL MINNESOTA

SUPERIOR, WISCONSIN

DATE JAN 15, 1976 COMM 6888N

SOUTH SUPERIOR – DISTRICT 5
STORM SEWER

SHEET 13/17

60th ST BANKS AVE.
59th ST CUMMINGS AVE.