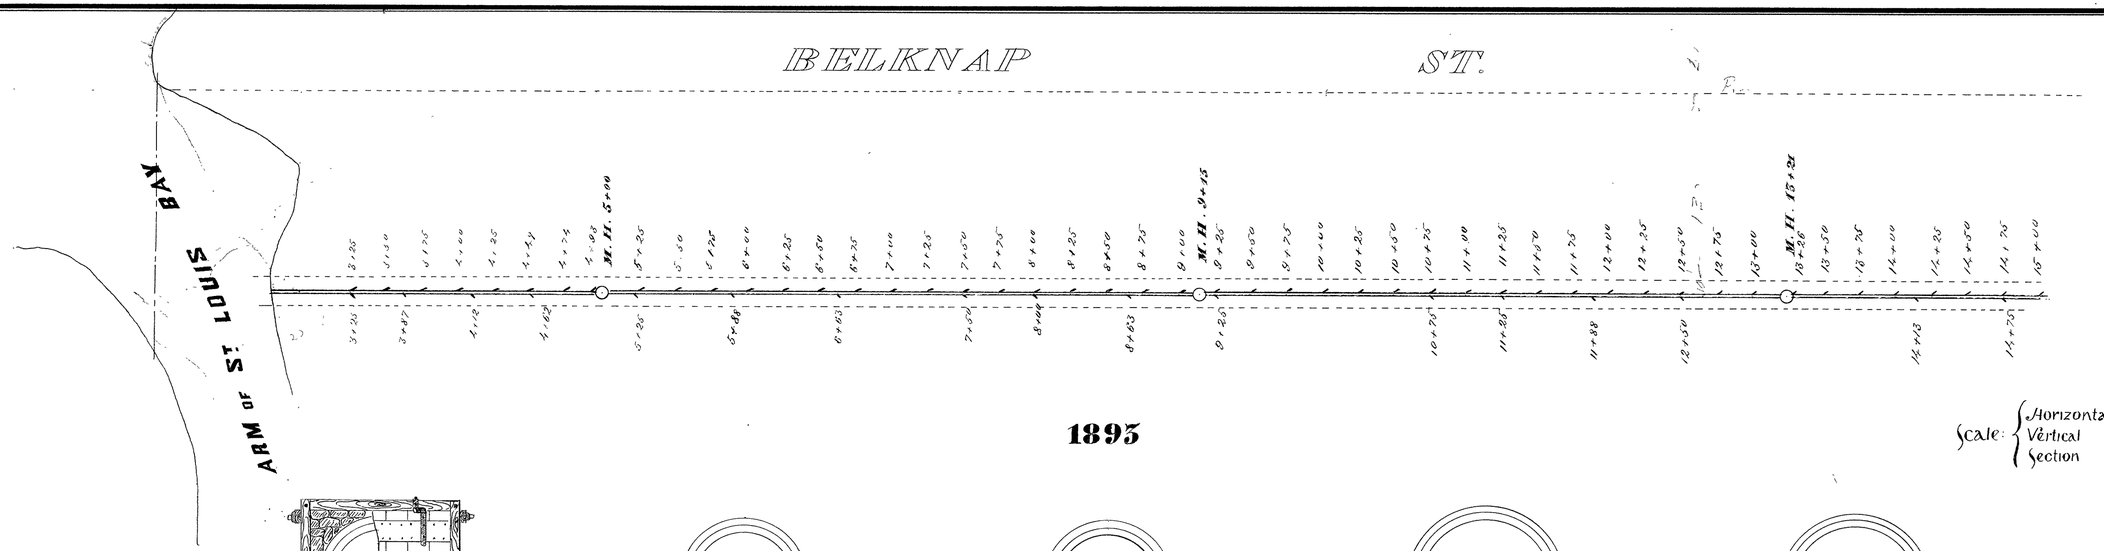

1893

Scale: Horizontal 60 ft. = 1 inch
Vertical 4 ft. = 1 inch
Section 4 ft. = 1 inch

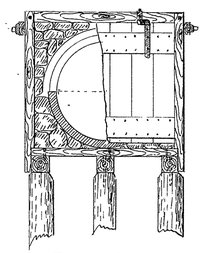

End View

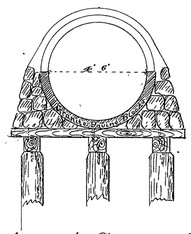

Section of 4'6" Sewer on Piles

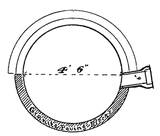

Section of 4'6" Sewer

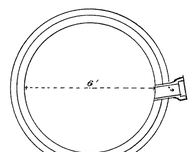

Section of 6'0" Sewer

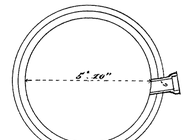

Section of 5'10" Sewer

CITY OF SUPERIOR

SEWER PLAN

Contract let June 9, 1892
" completed Nov. 18, 1892
Kirkland & Starkey, Contractor
Joseph P. Duff, Inspector
A. S. Cooper, City Engr.

Plan & Profile of Sewer in Alley between Belknap & 16th St. from Bay East.

6-1