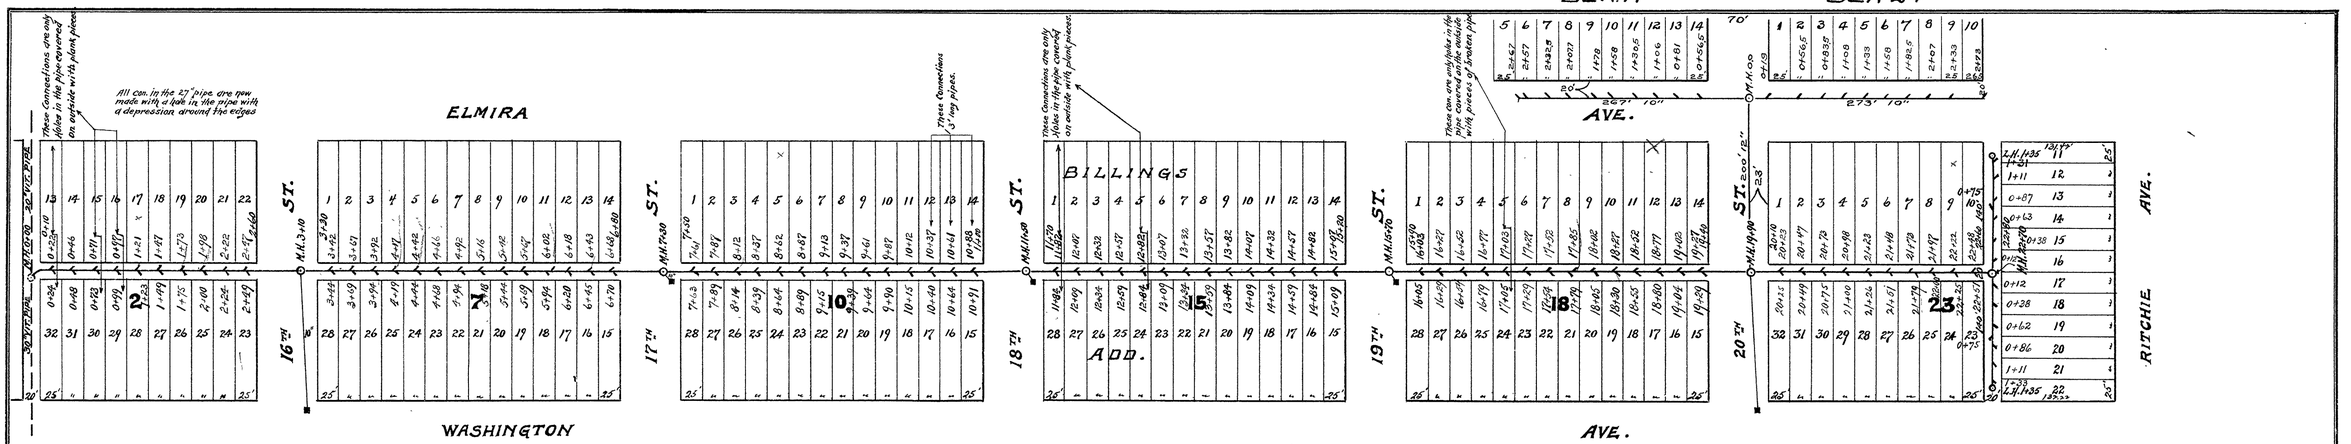


Horizontal Scale: 1in.= 100ft.
Vertical Scale: 1in.= 4 ft.

CONTRACT Nº 1506

Contract let JAN. 22 16
Contract completed OCT. 2 17
Sid Riches & Son ____ Contractor
Andr. Solin ____ Inspector
E.B. Banks ____ City Engineer

RICHES CEMENT PIPE USED

# SEWER IN 20TH ST. AND ELMIRA AVE.

## CONTRACT Nº 1705 CONTRACT COMPLETED OCT. 5TH 1925

## BYRON KIMBALL INSP'R. MAGNUS PETERSON CONT'R. E.B. BANKS CITY ENG'R.

IN 20TH ST. EAST FROM ALLEY

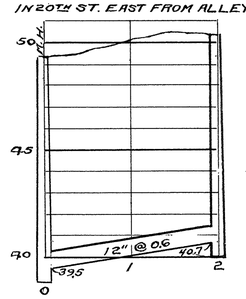


IN ELMIRA AVE. NORTH OF 20TH ST.

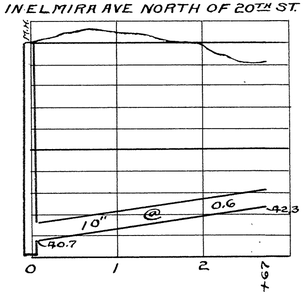

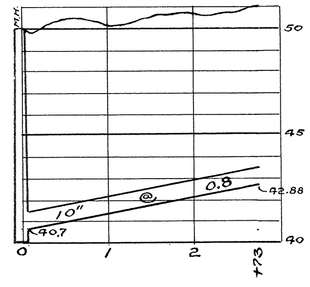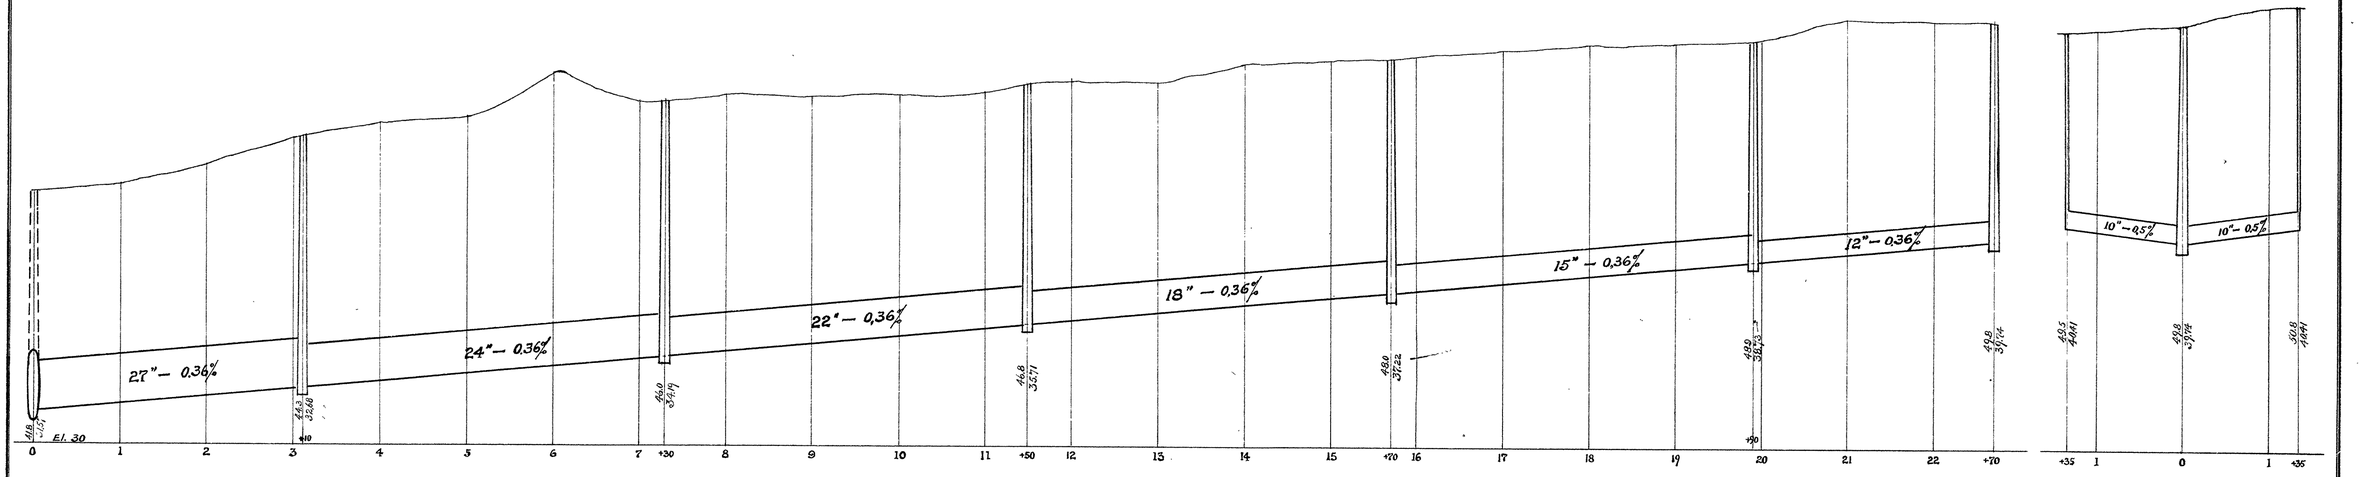
IN ELMIRA AVE. SOUTH OF 20TH ST.