


STORAGE

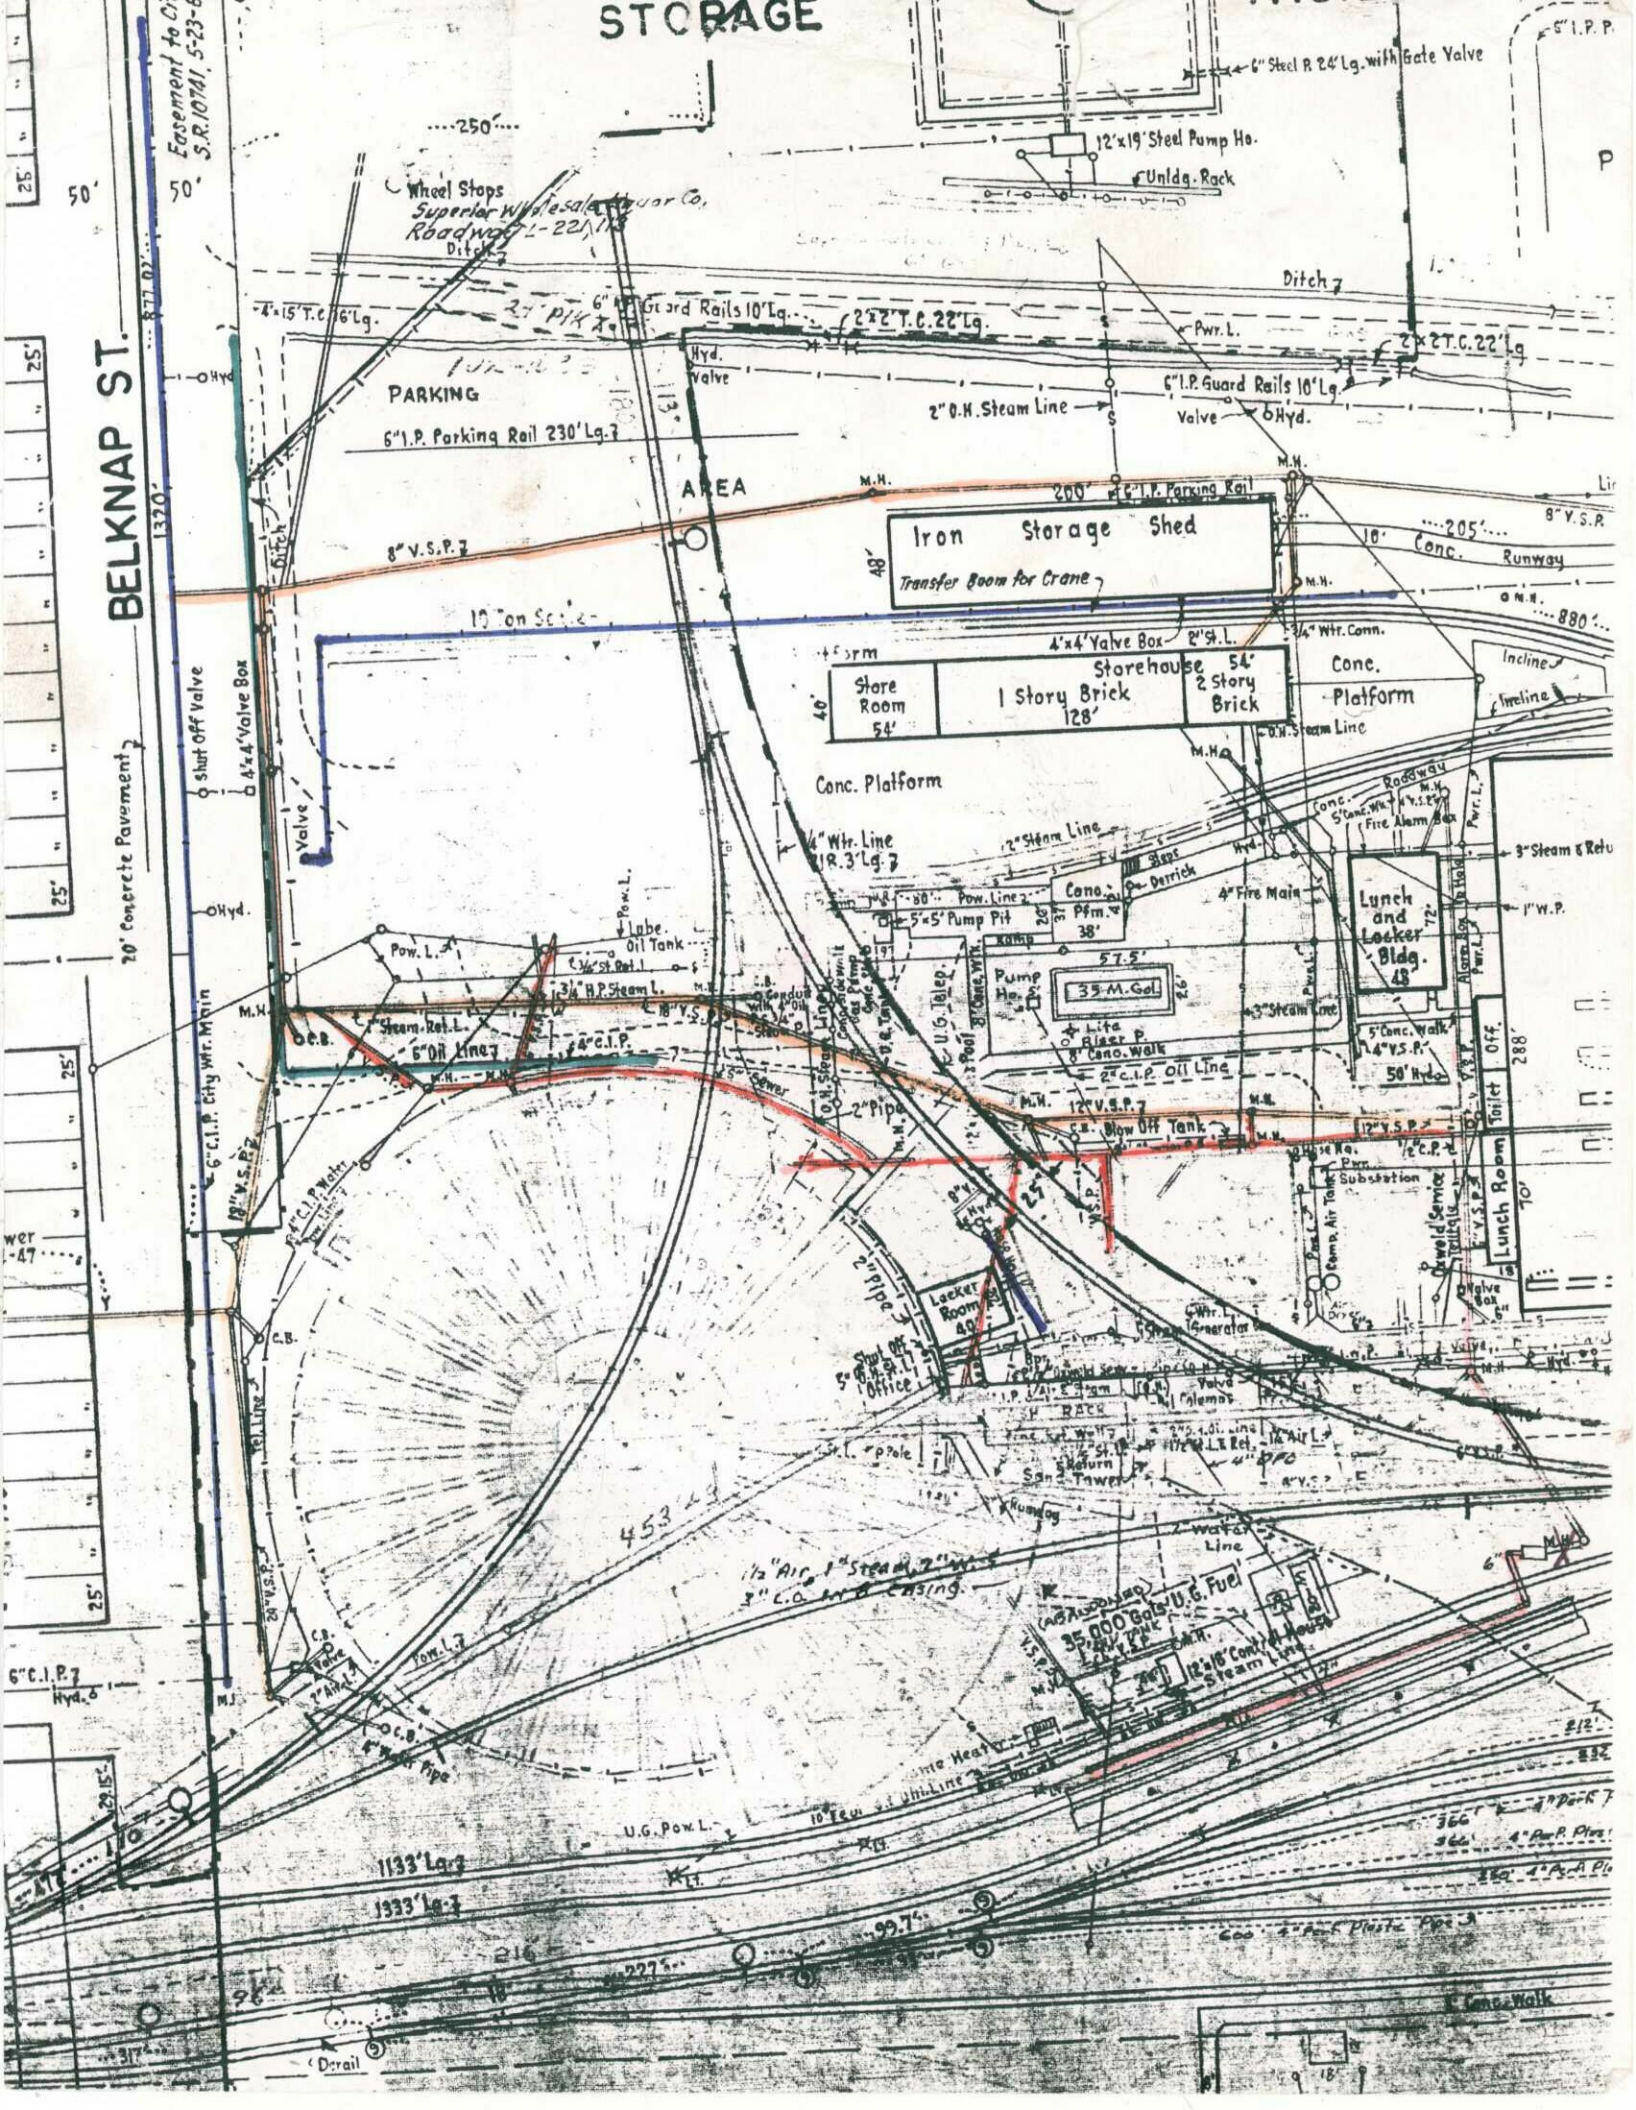

BELKNAP ST.

20' concrete Pavement

50'

50'

25'

25'

25'

25'

25'

25'

25'

Easement to City
S.R. 10741, 5-23-6

1320'






Wheel Stops
Superior Wholesale Tread Co.
Roadway 2-22-113
Ditch

PARKING
6" I.P. Parking Rail 230' Lg.

AREA
8" V.S.P.
10' on Sec. 2

Store Room 54'
1 Story Brick Storehouse 54' x 128'
2 Story Brick Storehouse 54' x 128'

Conc. Platform
4" Wtr. Line 18.3' Lg.

35 M. Gal. Tank
8' Conc. Walk
2" C.I.P. Oil Line

Locker Room 40'
Office
5' x 10' x 10'

35,000 Gals U.G. Fuel Tank
2" Wtr. Cont. House
Steam Line

1133' Lg.
1333' Lg.
99.7'

216
227

Iron Storage Shed
Transfer Room for Crane








453

1 1/2" Air & Steam 2" Wtr. 3" C.O. and casing








6" I.P.P.
P

Ditch 7

6" I.P. Guard Rails 10' Lg. Valve 6 Hyd.

10' Conc. Runway

3" Steam & Retu

1" W.P.

5' Conc. Walk 14" V.S.P.

50' Hyd.

12" V.S.P.

12" V.S.P.

212'

232'

356'

366'





