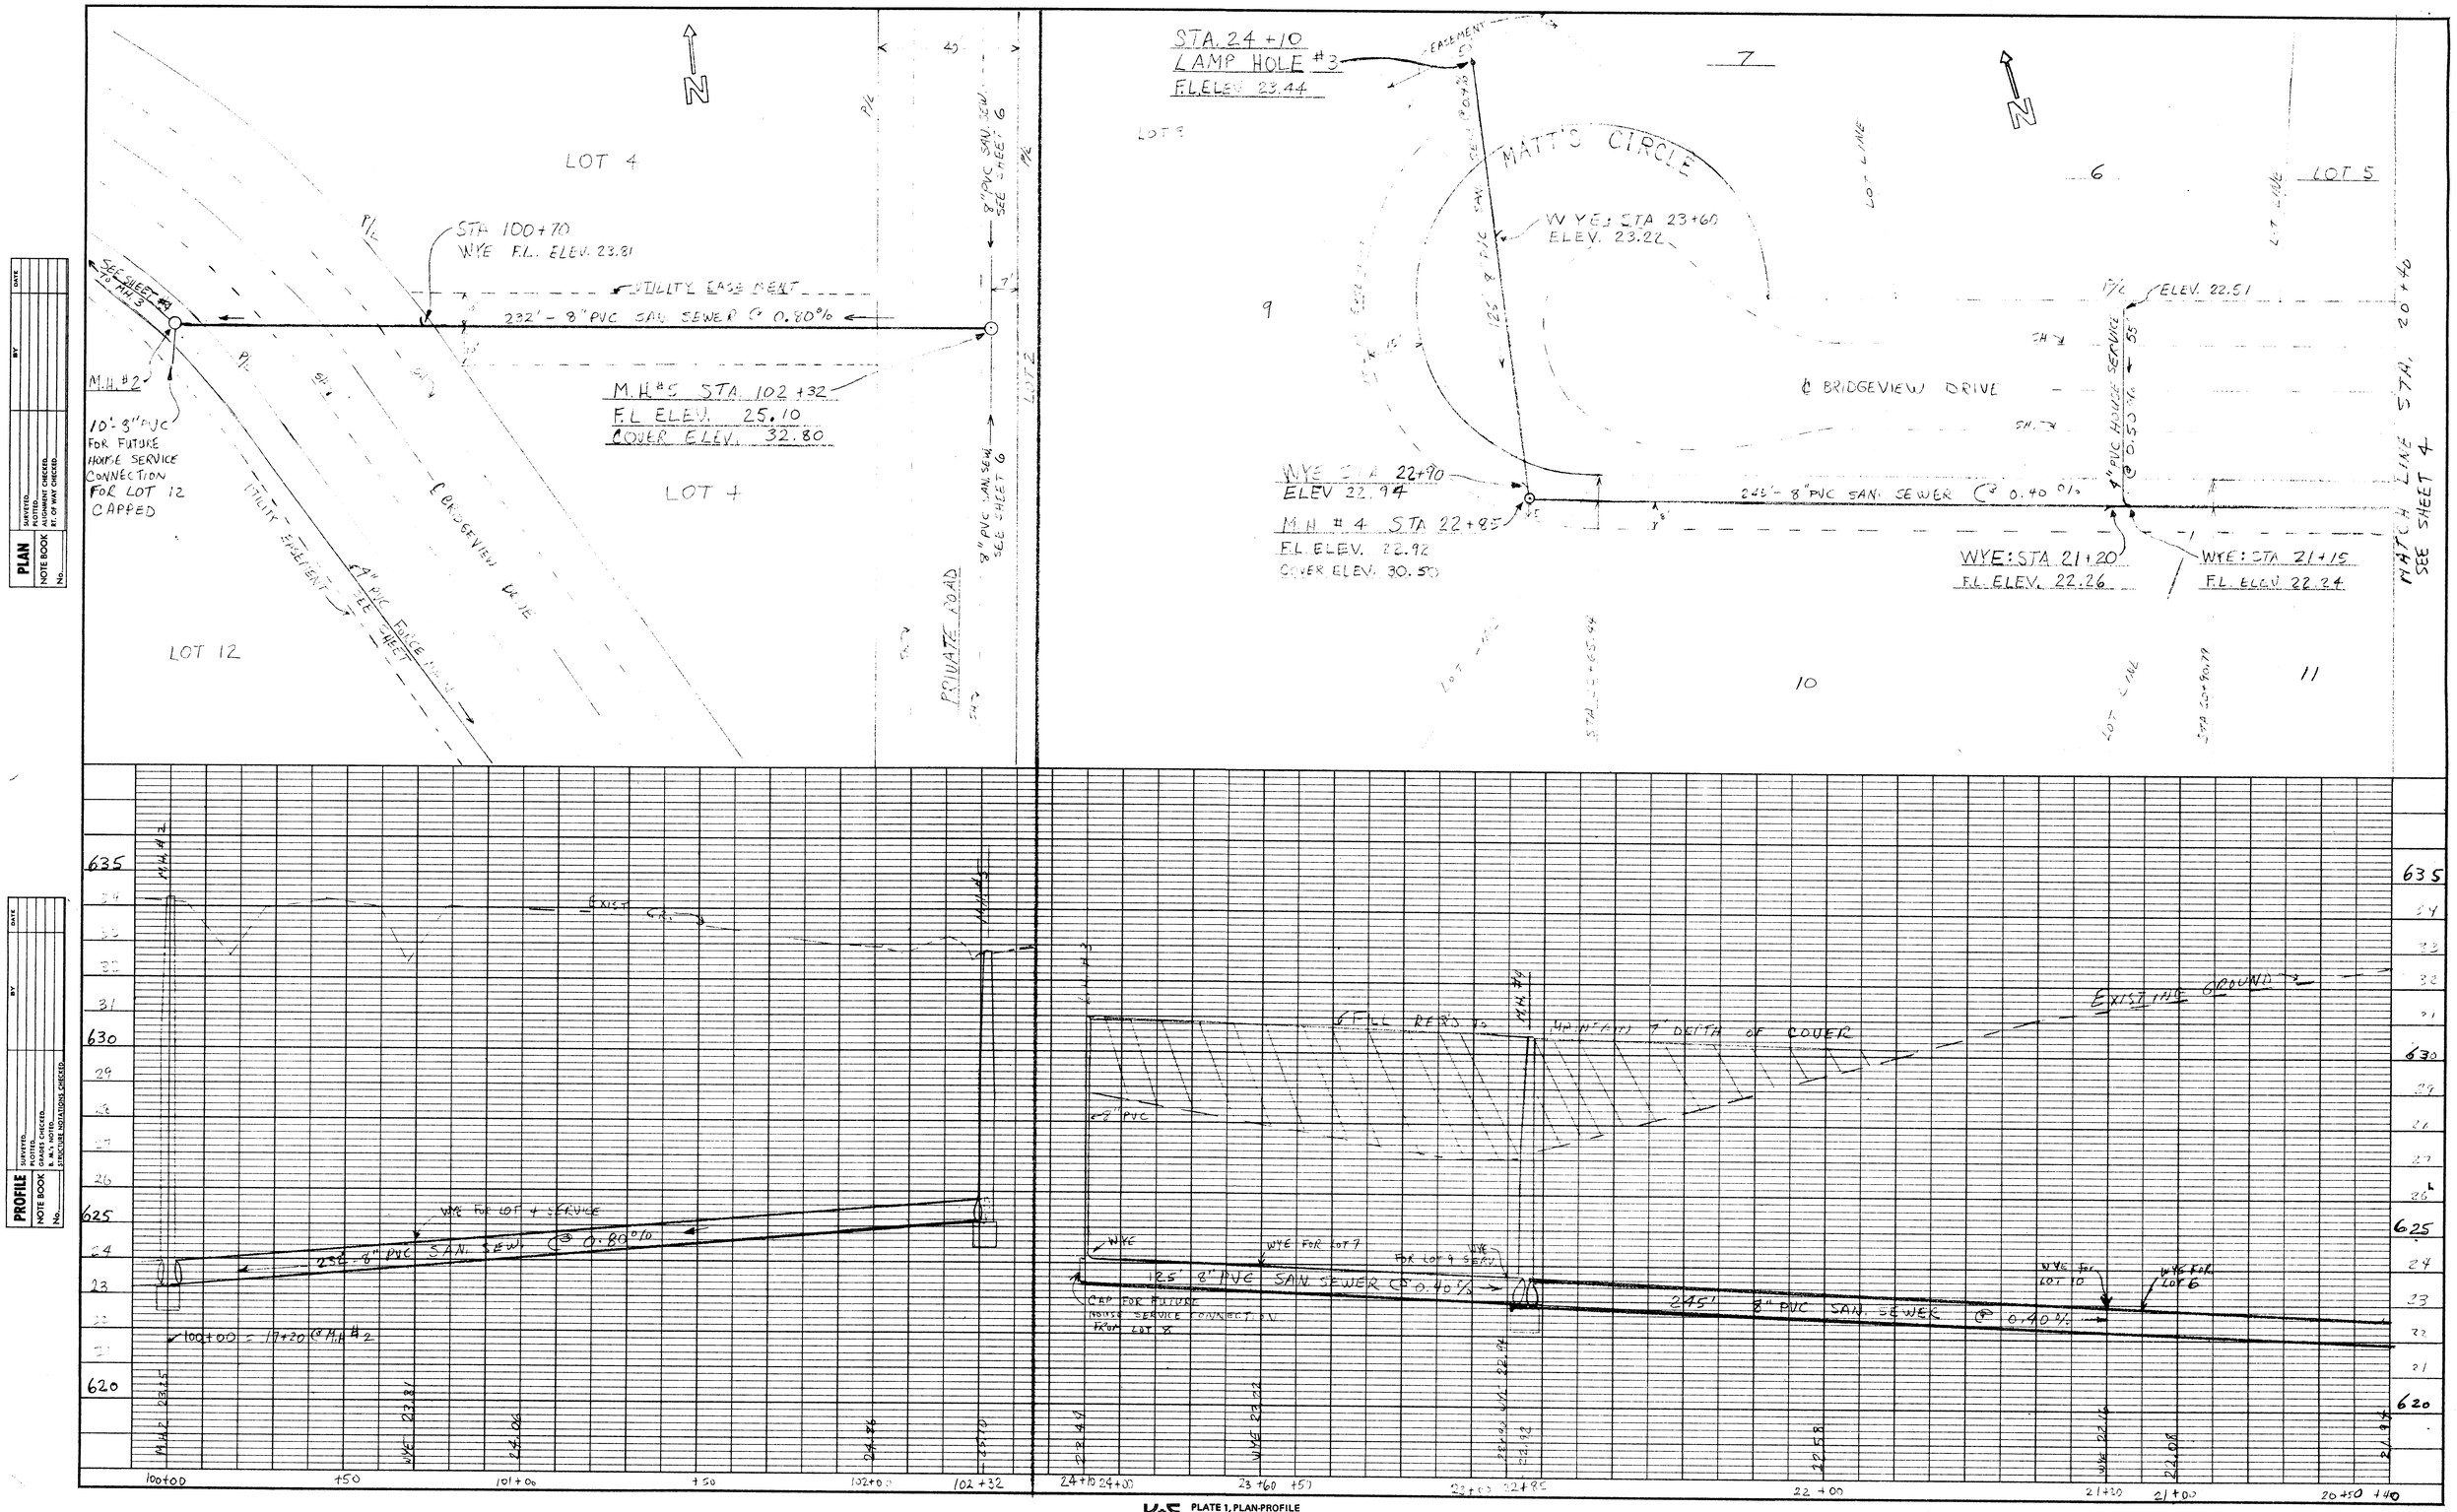

PLAN
NOTE BOOK No.
SURVEYED
PLOTTED
ALIGNMENT CHECKED
RT. OF WAY CHECKED
BY
DATE

PROFILE
NOTE BOOK No.
SURVEYED
PLOTTED
GRADES CHECKED
B. M.'s NOTED
STRUCTURE NOTATIONS CHECKED
BY
DATE

K+E PLATE 1, PLAN-PROFILE
KEUFFEL & ESSER CO.
48 7008 Made in U.S.A.

SHEET 5 OF 6