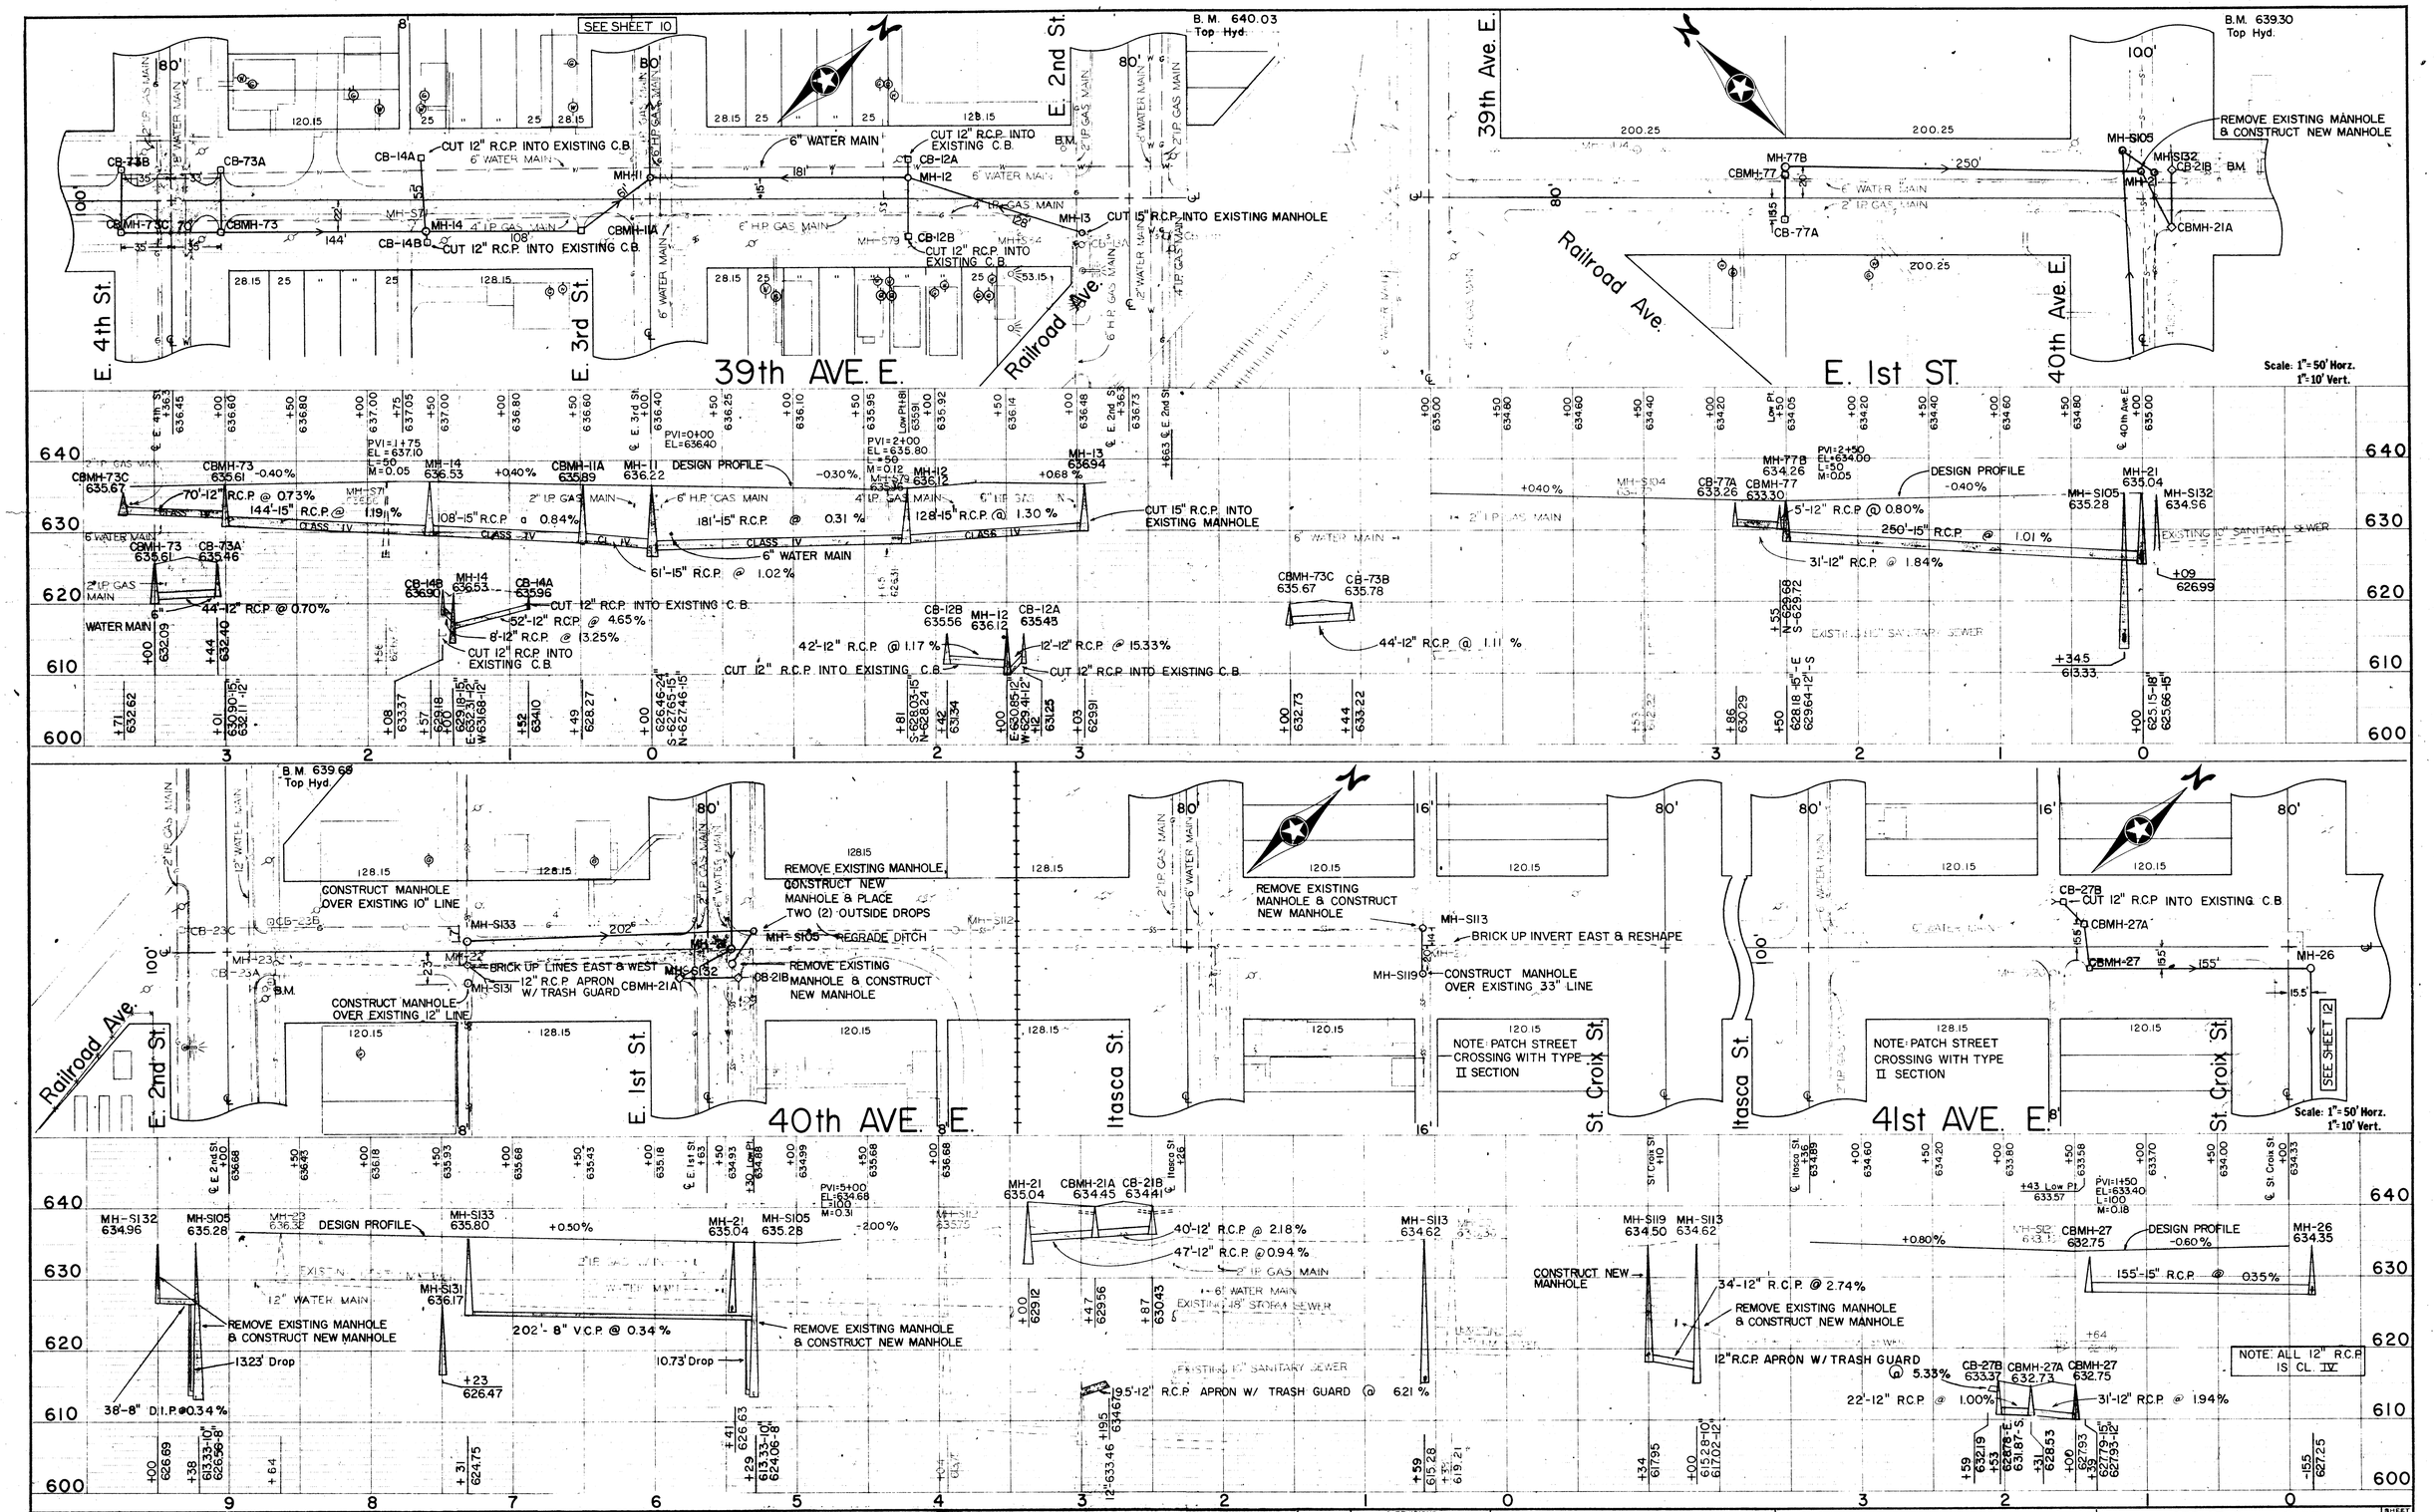

I HEREBY CERTIFY THAT THIS PLAN WAS PREPARED BY ME OR UNDER MY DIRECT SUPERVISION AND THAT I AM A DULY REGISTERED PROFESSIONAL ENGINEER UNDER THE LAWS OF THE STATE OF WISCONSIN.

DATE: May 15, 1974 REG. NO. E06599

SURVEY	DE	REVISIONS	
DRAWN	TGB	RECORD PLAN	
DESIGN	JB	12/29/76 HBR	
APPROV'D	GRC		

BONESTROO, ROSENE, ANDERLIK & ASSOC., INC.
ST. PAUL, MINNESOTA

SUPERIOR, WISCONSIN
DATE: MARCH 8, 1974 COMM. 6888 L

DISTRICT 7-ALLOUEZ
STORM SEWER

SHEET 11/20

E. 1st St.
39th Ave. E.
40th Ave. E.
41st Ave. E.