


DATE	
BY	
REVISION	
NO. DATE	
PLAN	
NOTE BOOK	
NO. CHECKED	
BY	
DATE	

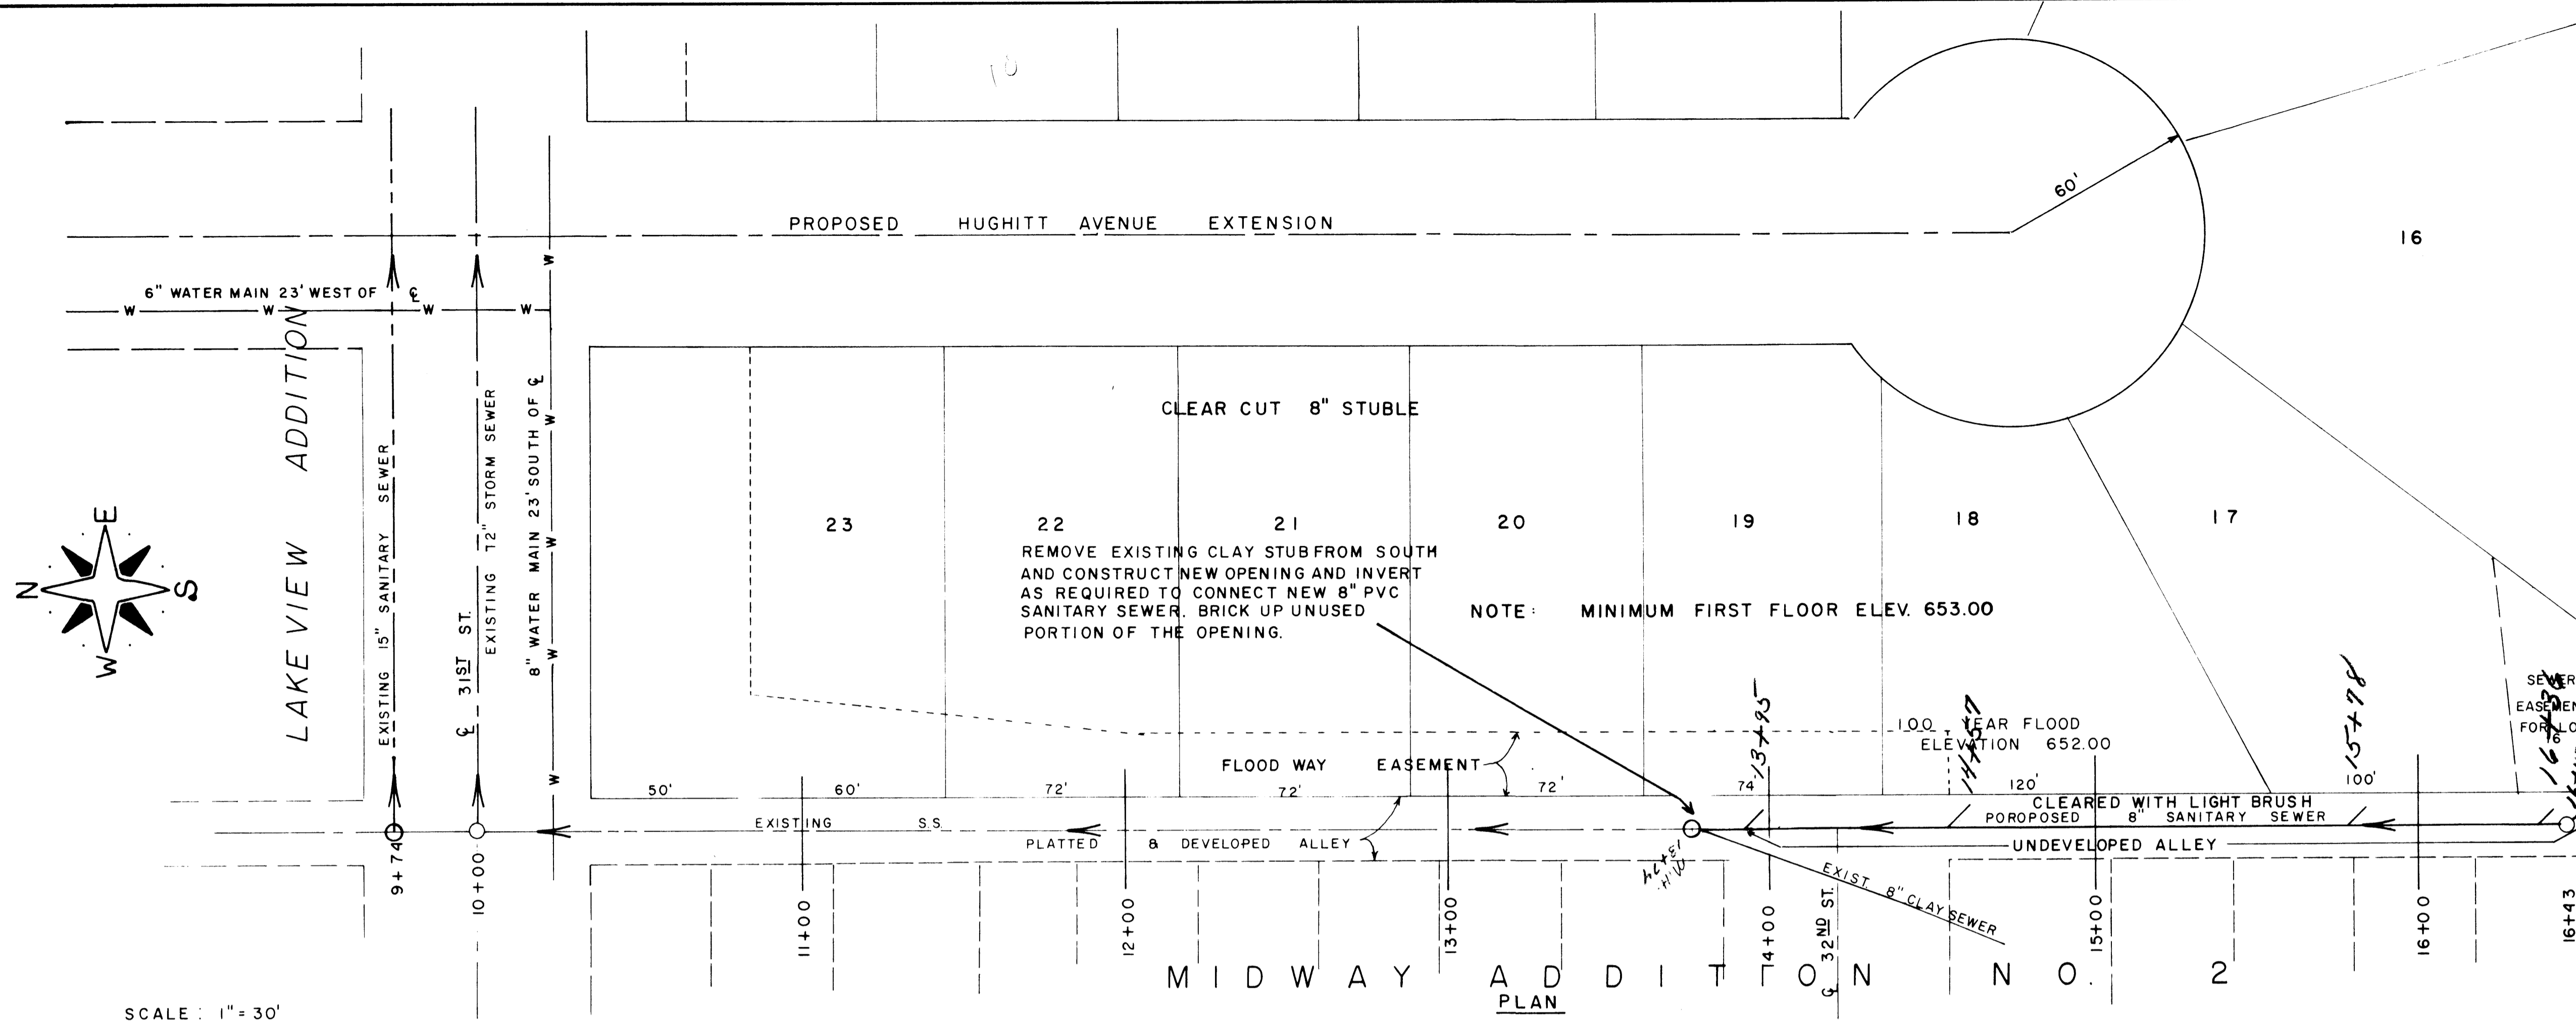


**WARNING**  
 ANY DAMAGE TO U  
 WHETHER SHOWN O.  
 IS THE CONTRACTOR  
 RESPONSIBILITY.

- NOTES:  
 STANDARD WYES AT THE FOLLOWING STATION
- 13 + 95 LEFT
  - 14 + 57 LEFT
  - 15 + 78 LEFT
  - 16 + 37 LEFT

SCALE: 1" = 30'

SCALE 1" = 30'

DATE	
BY	
REVISION	
NO. DATE	
PROFILE	
NOTE BOOK	
NO. CHECKED	
BY	
DATE	

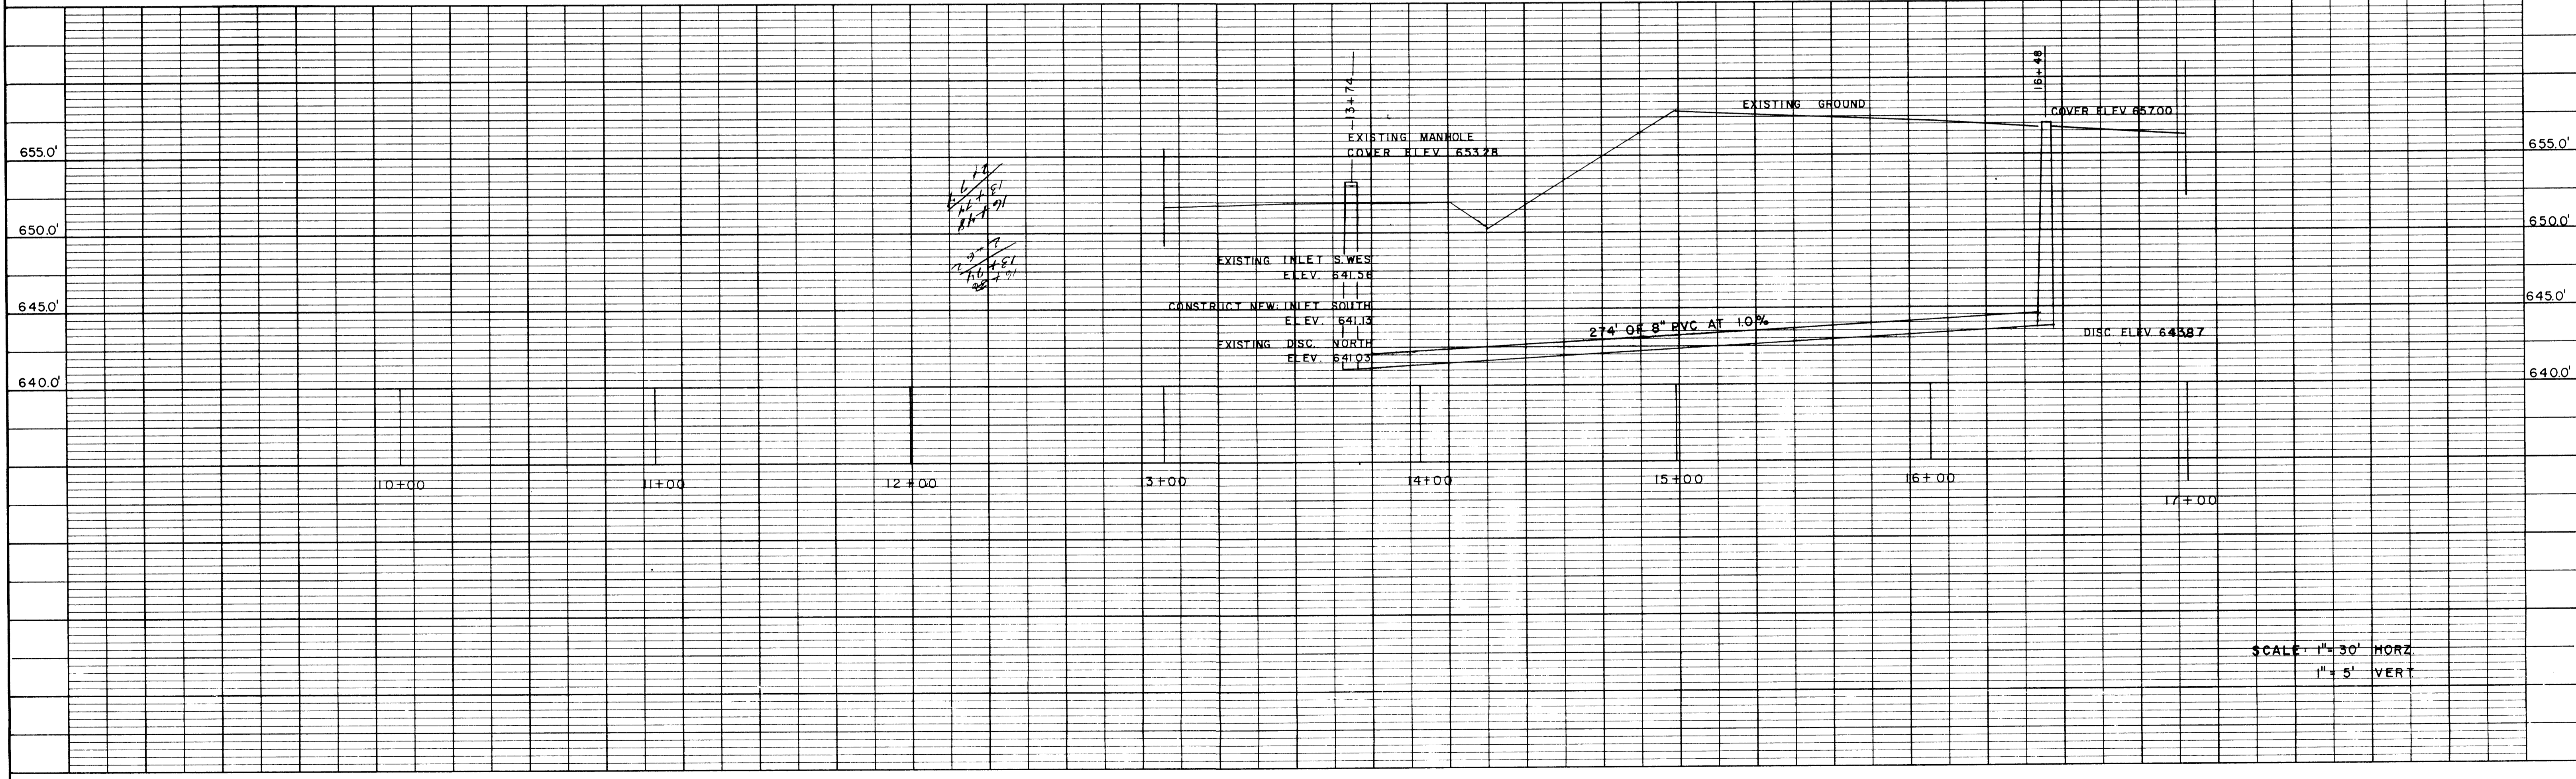

SCALE: 1" = 30' HORZ  
 1" = 5' VERT