



Prop. Revision 8/18/81

NOTA

- 1) PAYMENTS OF PIPE LAYING WITHOUT A CITY INSPECTOR PRESENT SHALL BE VOID.
- 2) ANY TRENCHING FOR UTILITY CROSSINGS SHALL BE MADE AT THE PROPERTY OWNER'S RISK AND UNDER THE SUPERVISION OF AN ENGINEER.
- 3) THE CONTRACTOR SHALL BE RESPONSIBLE FOR WATER, LIGHT AND GAS MAINS AND SHALL BE RESPONSIBLE FOR ANY DAMAGE TO SAME.

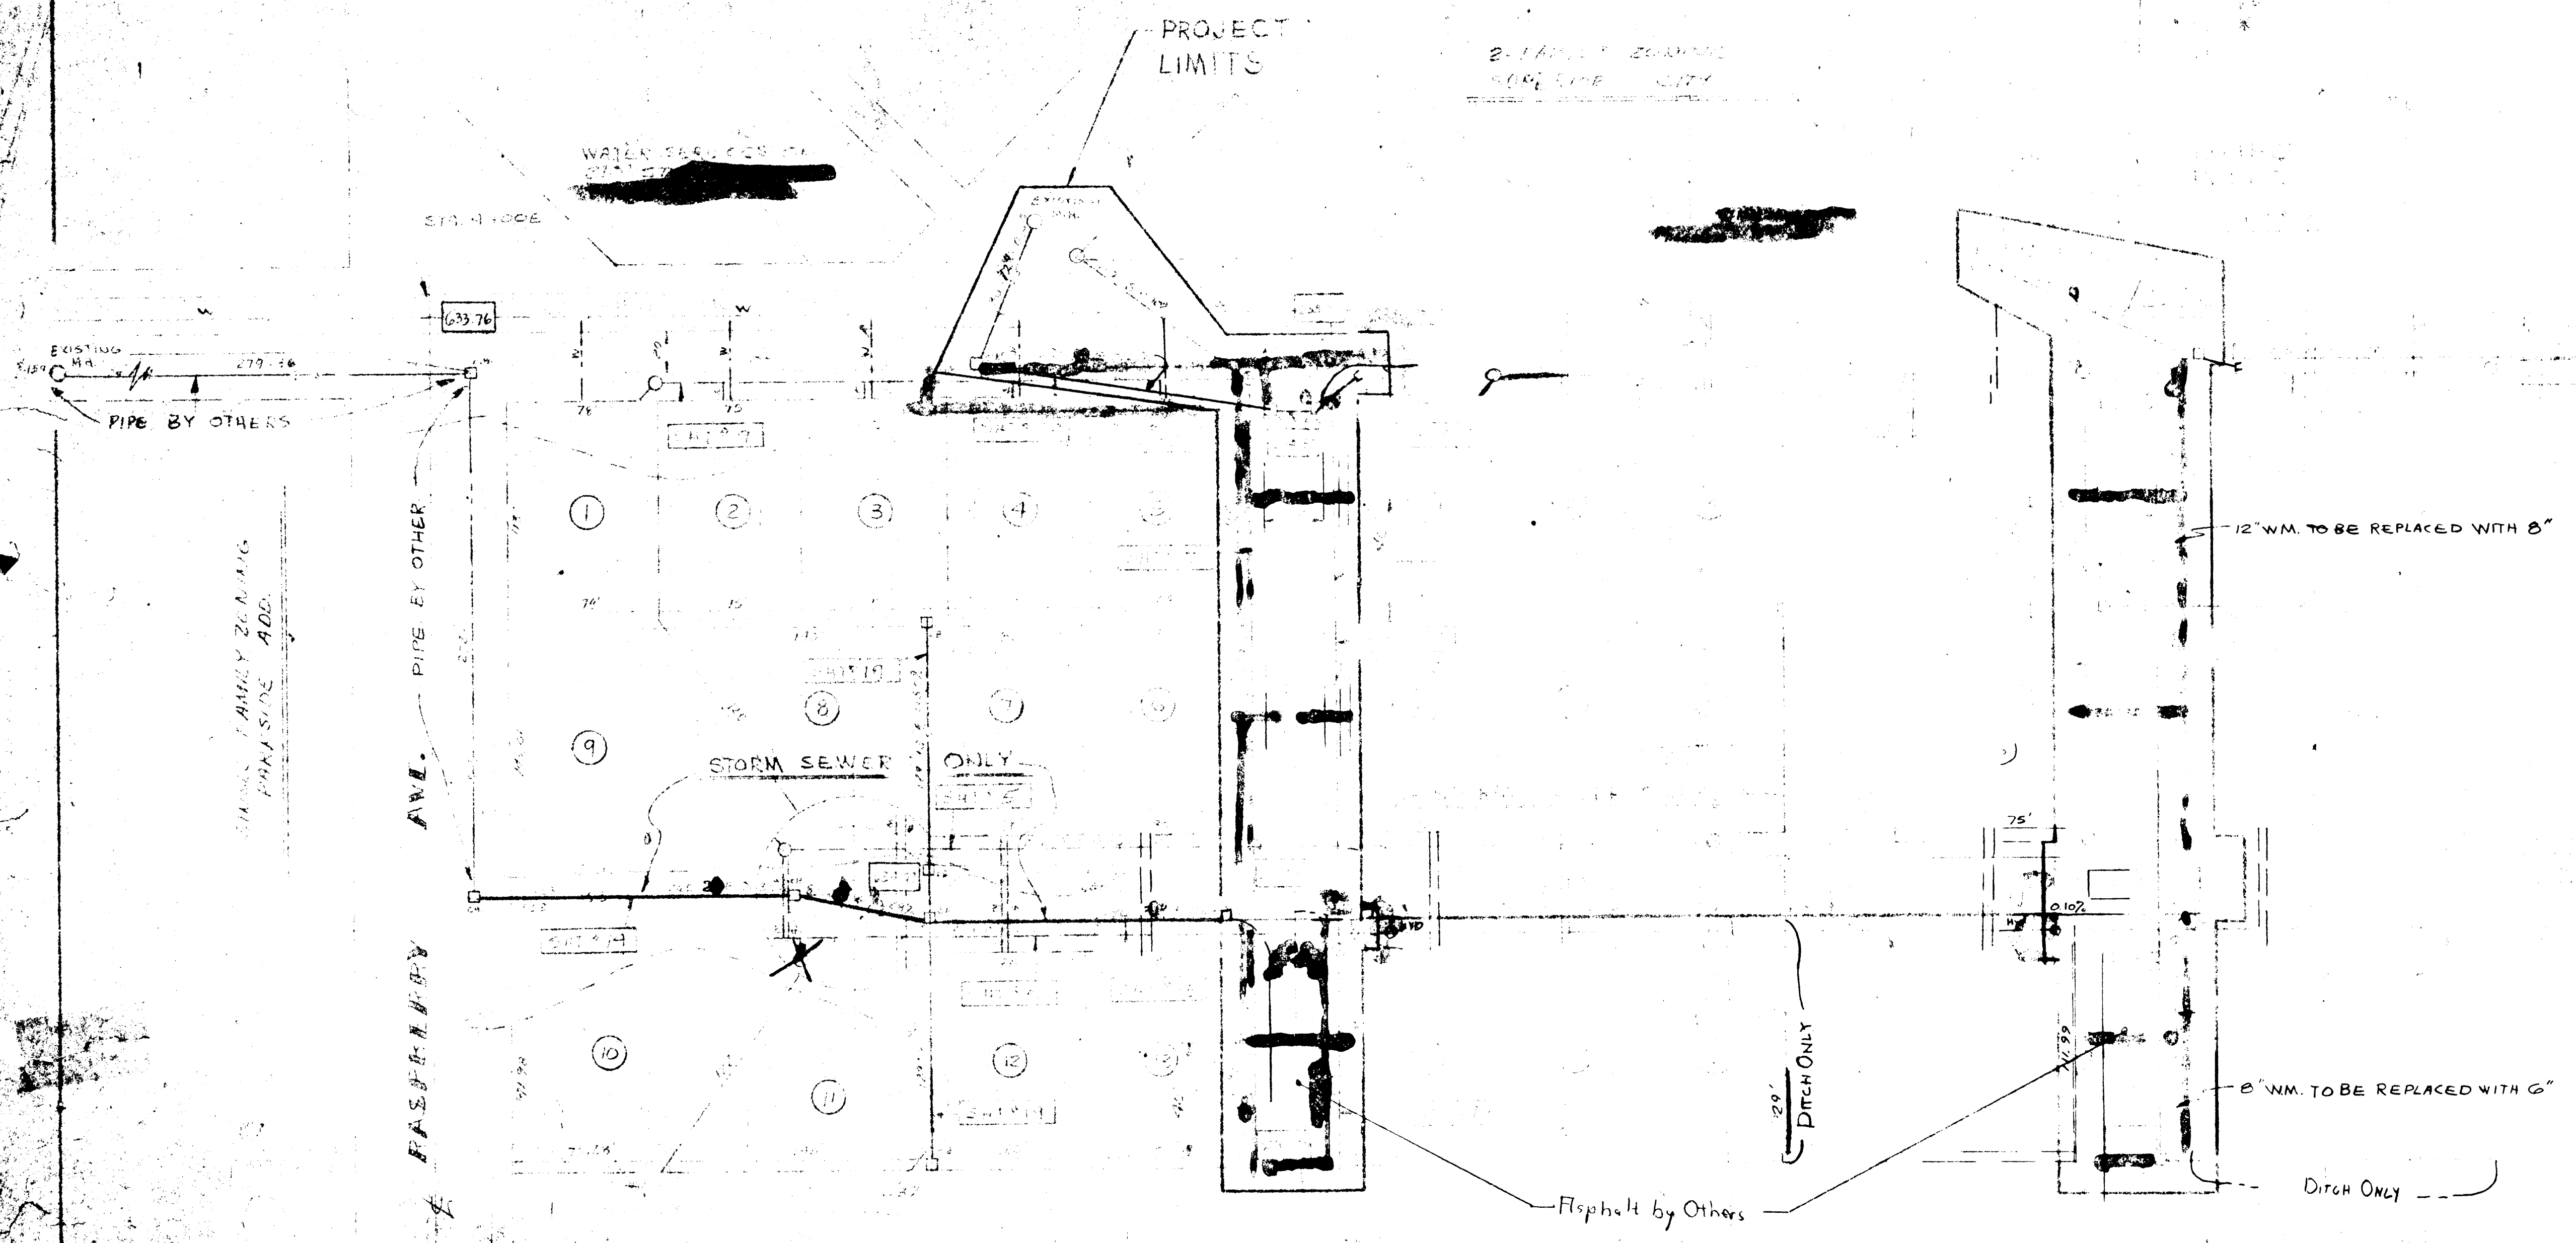

PLAN REVIEWED 6/26/88

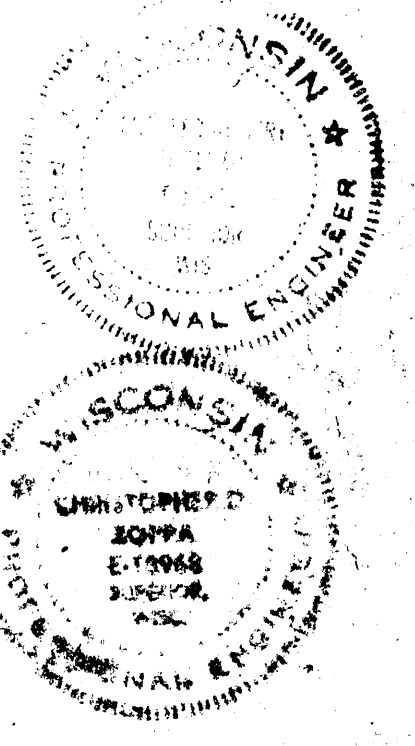

DATE 10-22-79 REVISED FOR BOTH PHASES
 DATE 10-9-79 REVISED FOR PHASE I

CITY OF SUPERIOR
 PUBLIC WORKS DEPARTMENT
 UTILITY SYSTEM PLAN