
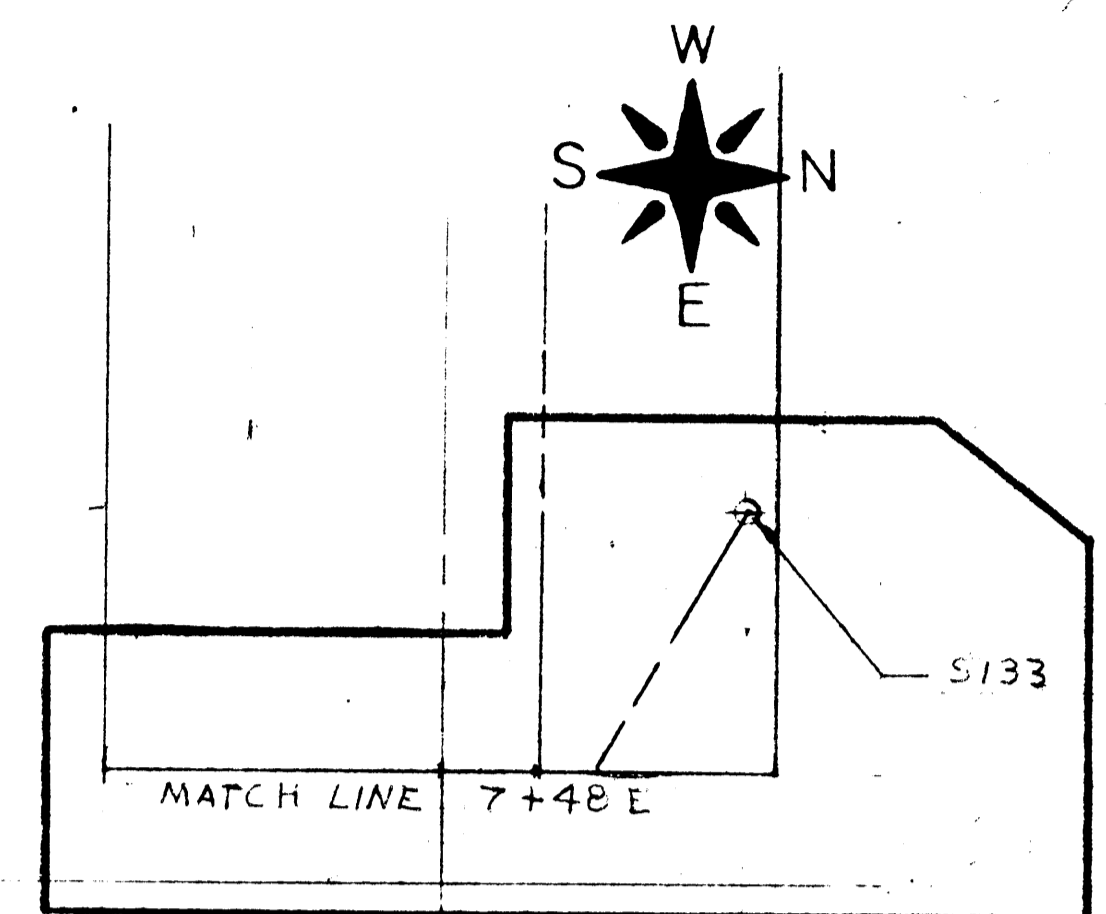


3
COLOR CODE


PLAN	SURVEYED	DATE
	BY	
	NO. 1	
	NO. 2	
ULLVILLE

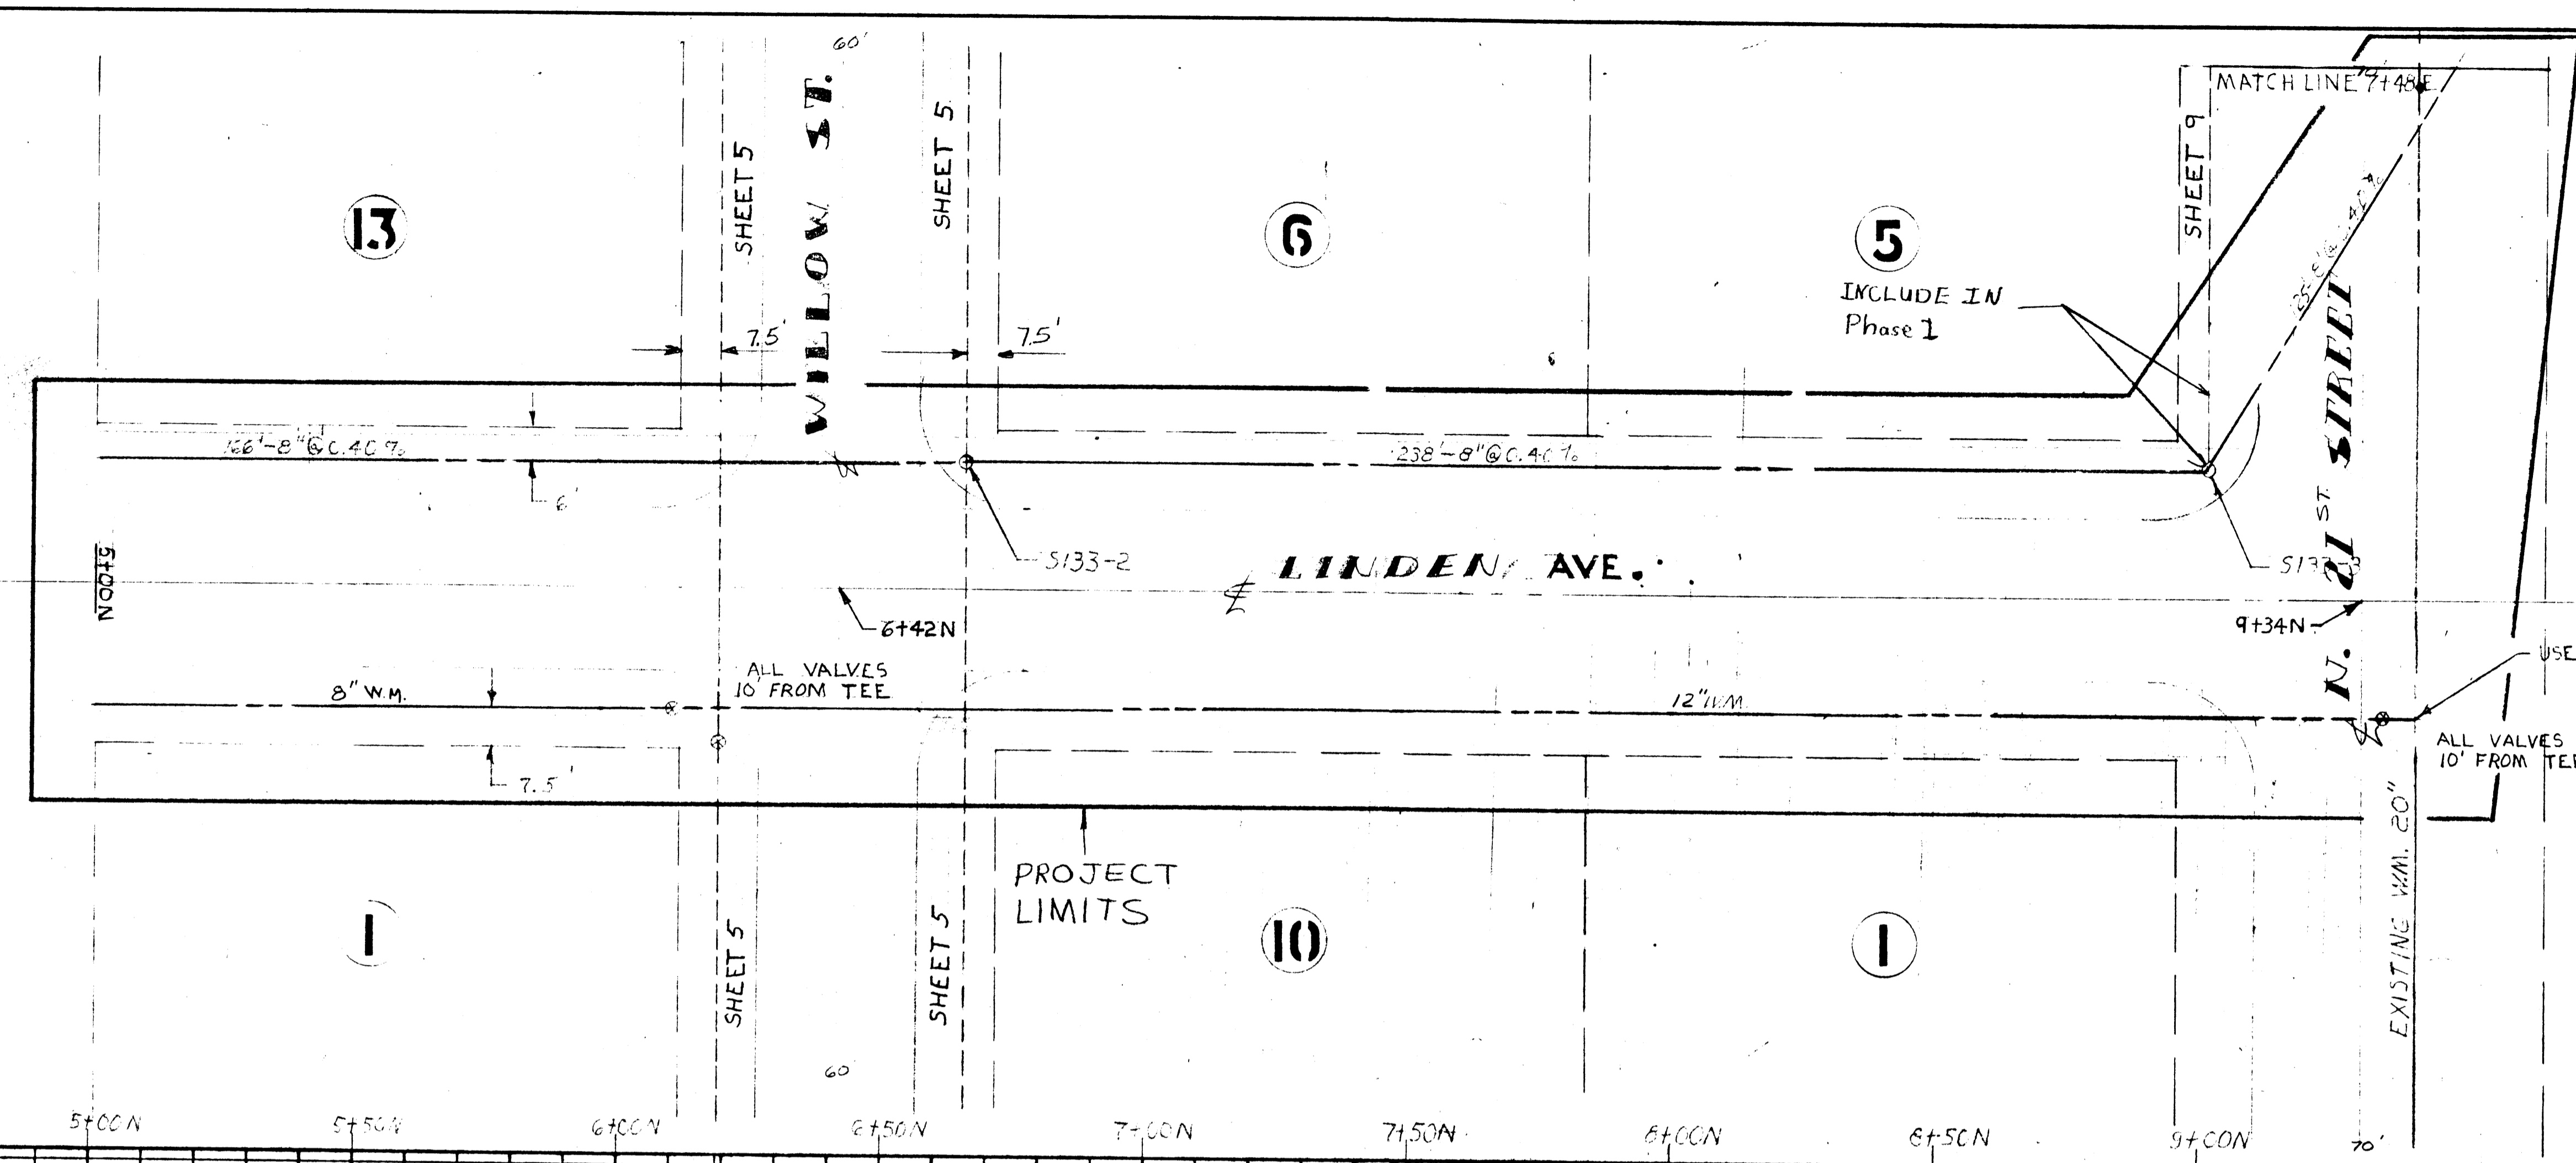


SANITARY SEWER & WATER MAIN LINDEN ST.
 DRN: LLOYD BRANNAN
 DESIGN: CHRIS ZOPPA
 CHECK: CHRIS ZOPPA

SCALE 1"=20'

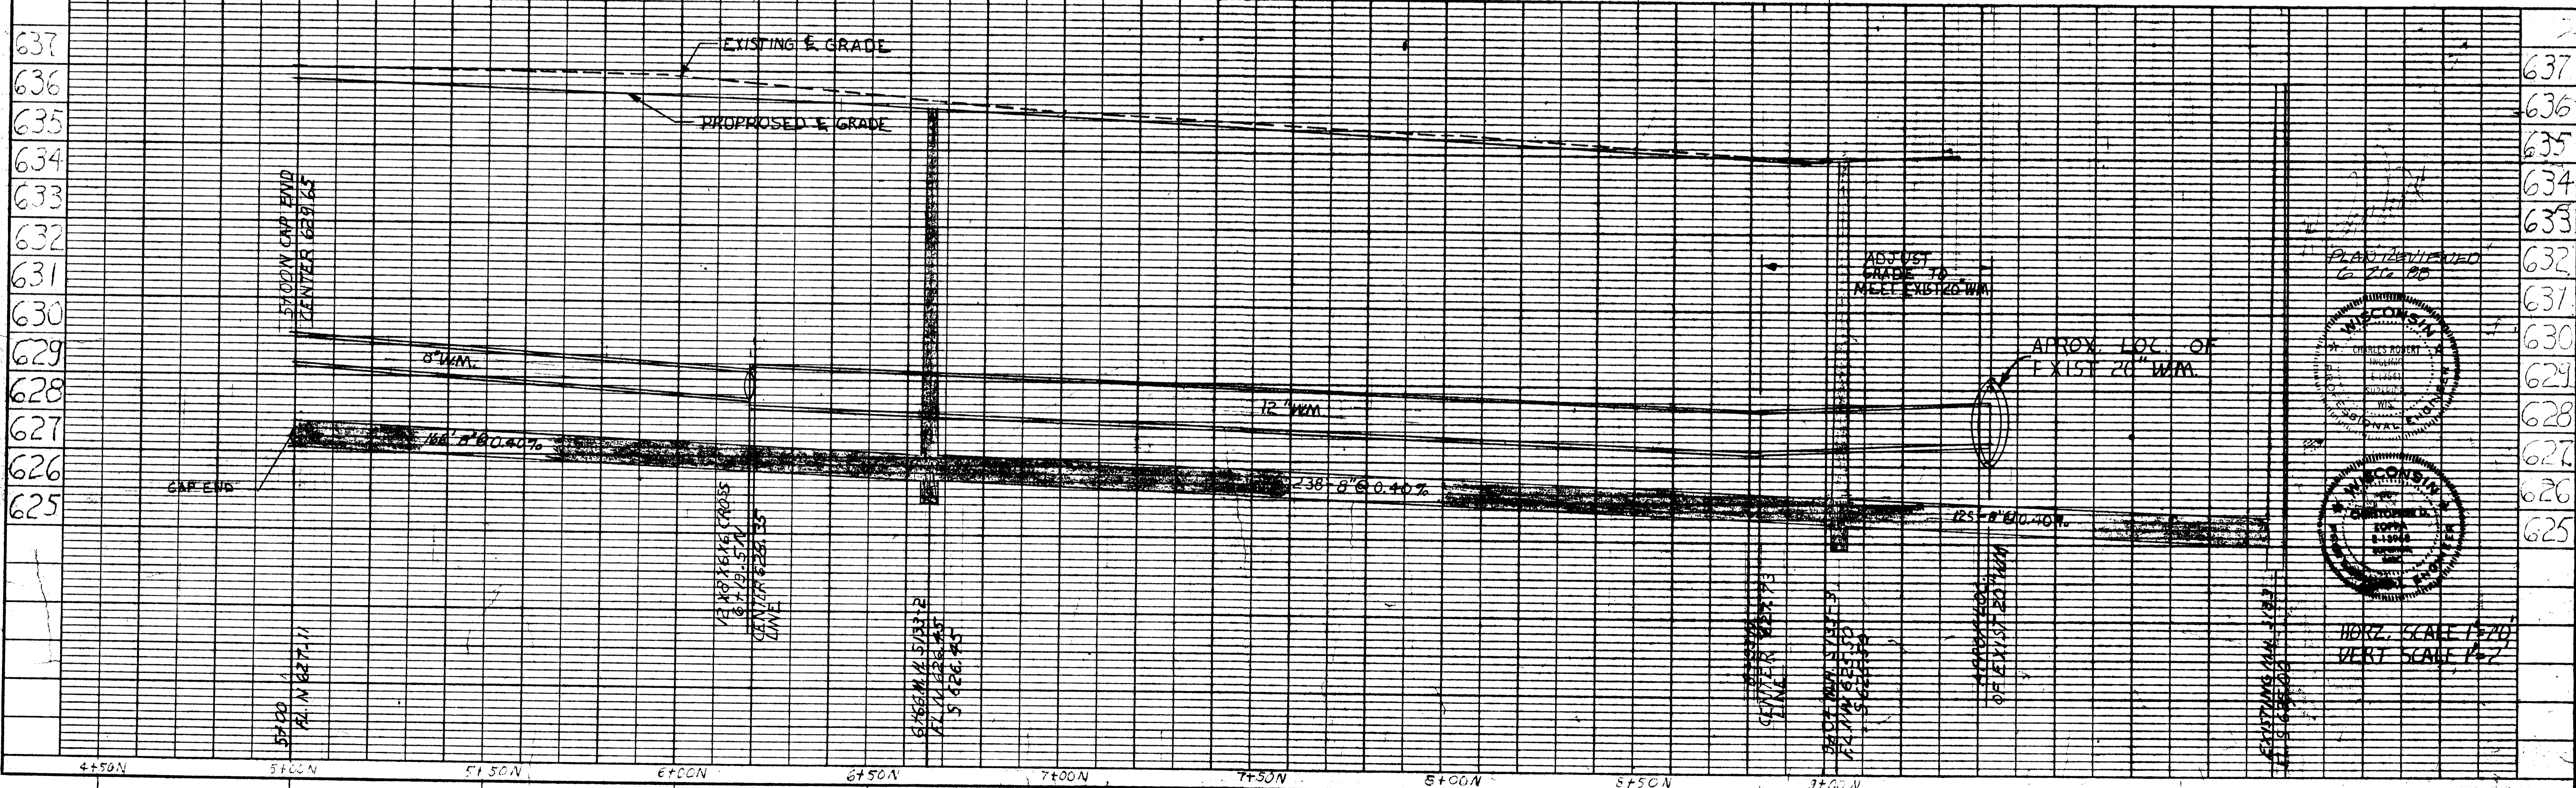

PROFILE	SURVEYED	DATE
	BY	
	NO. 1	
	NO. 2	
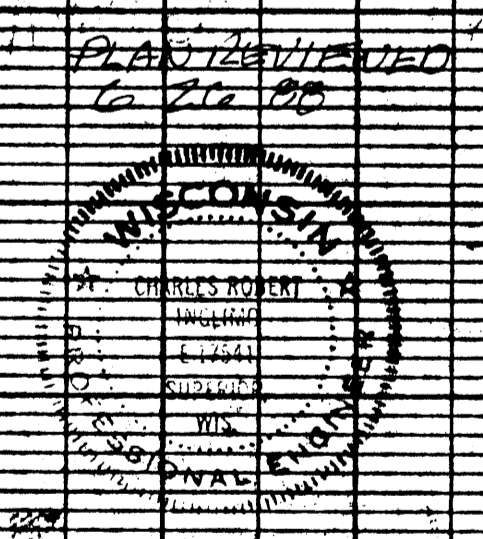

HORIZ. SCALE 1"=20'
 VERT. SCALE 1"=2'