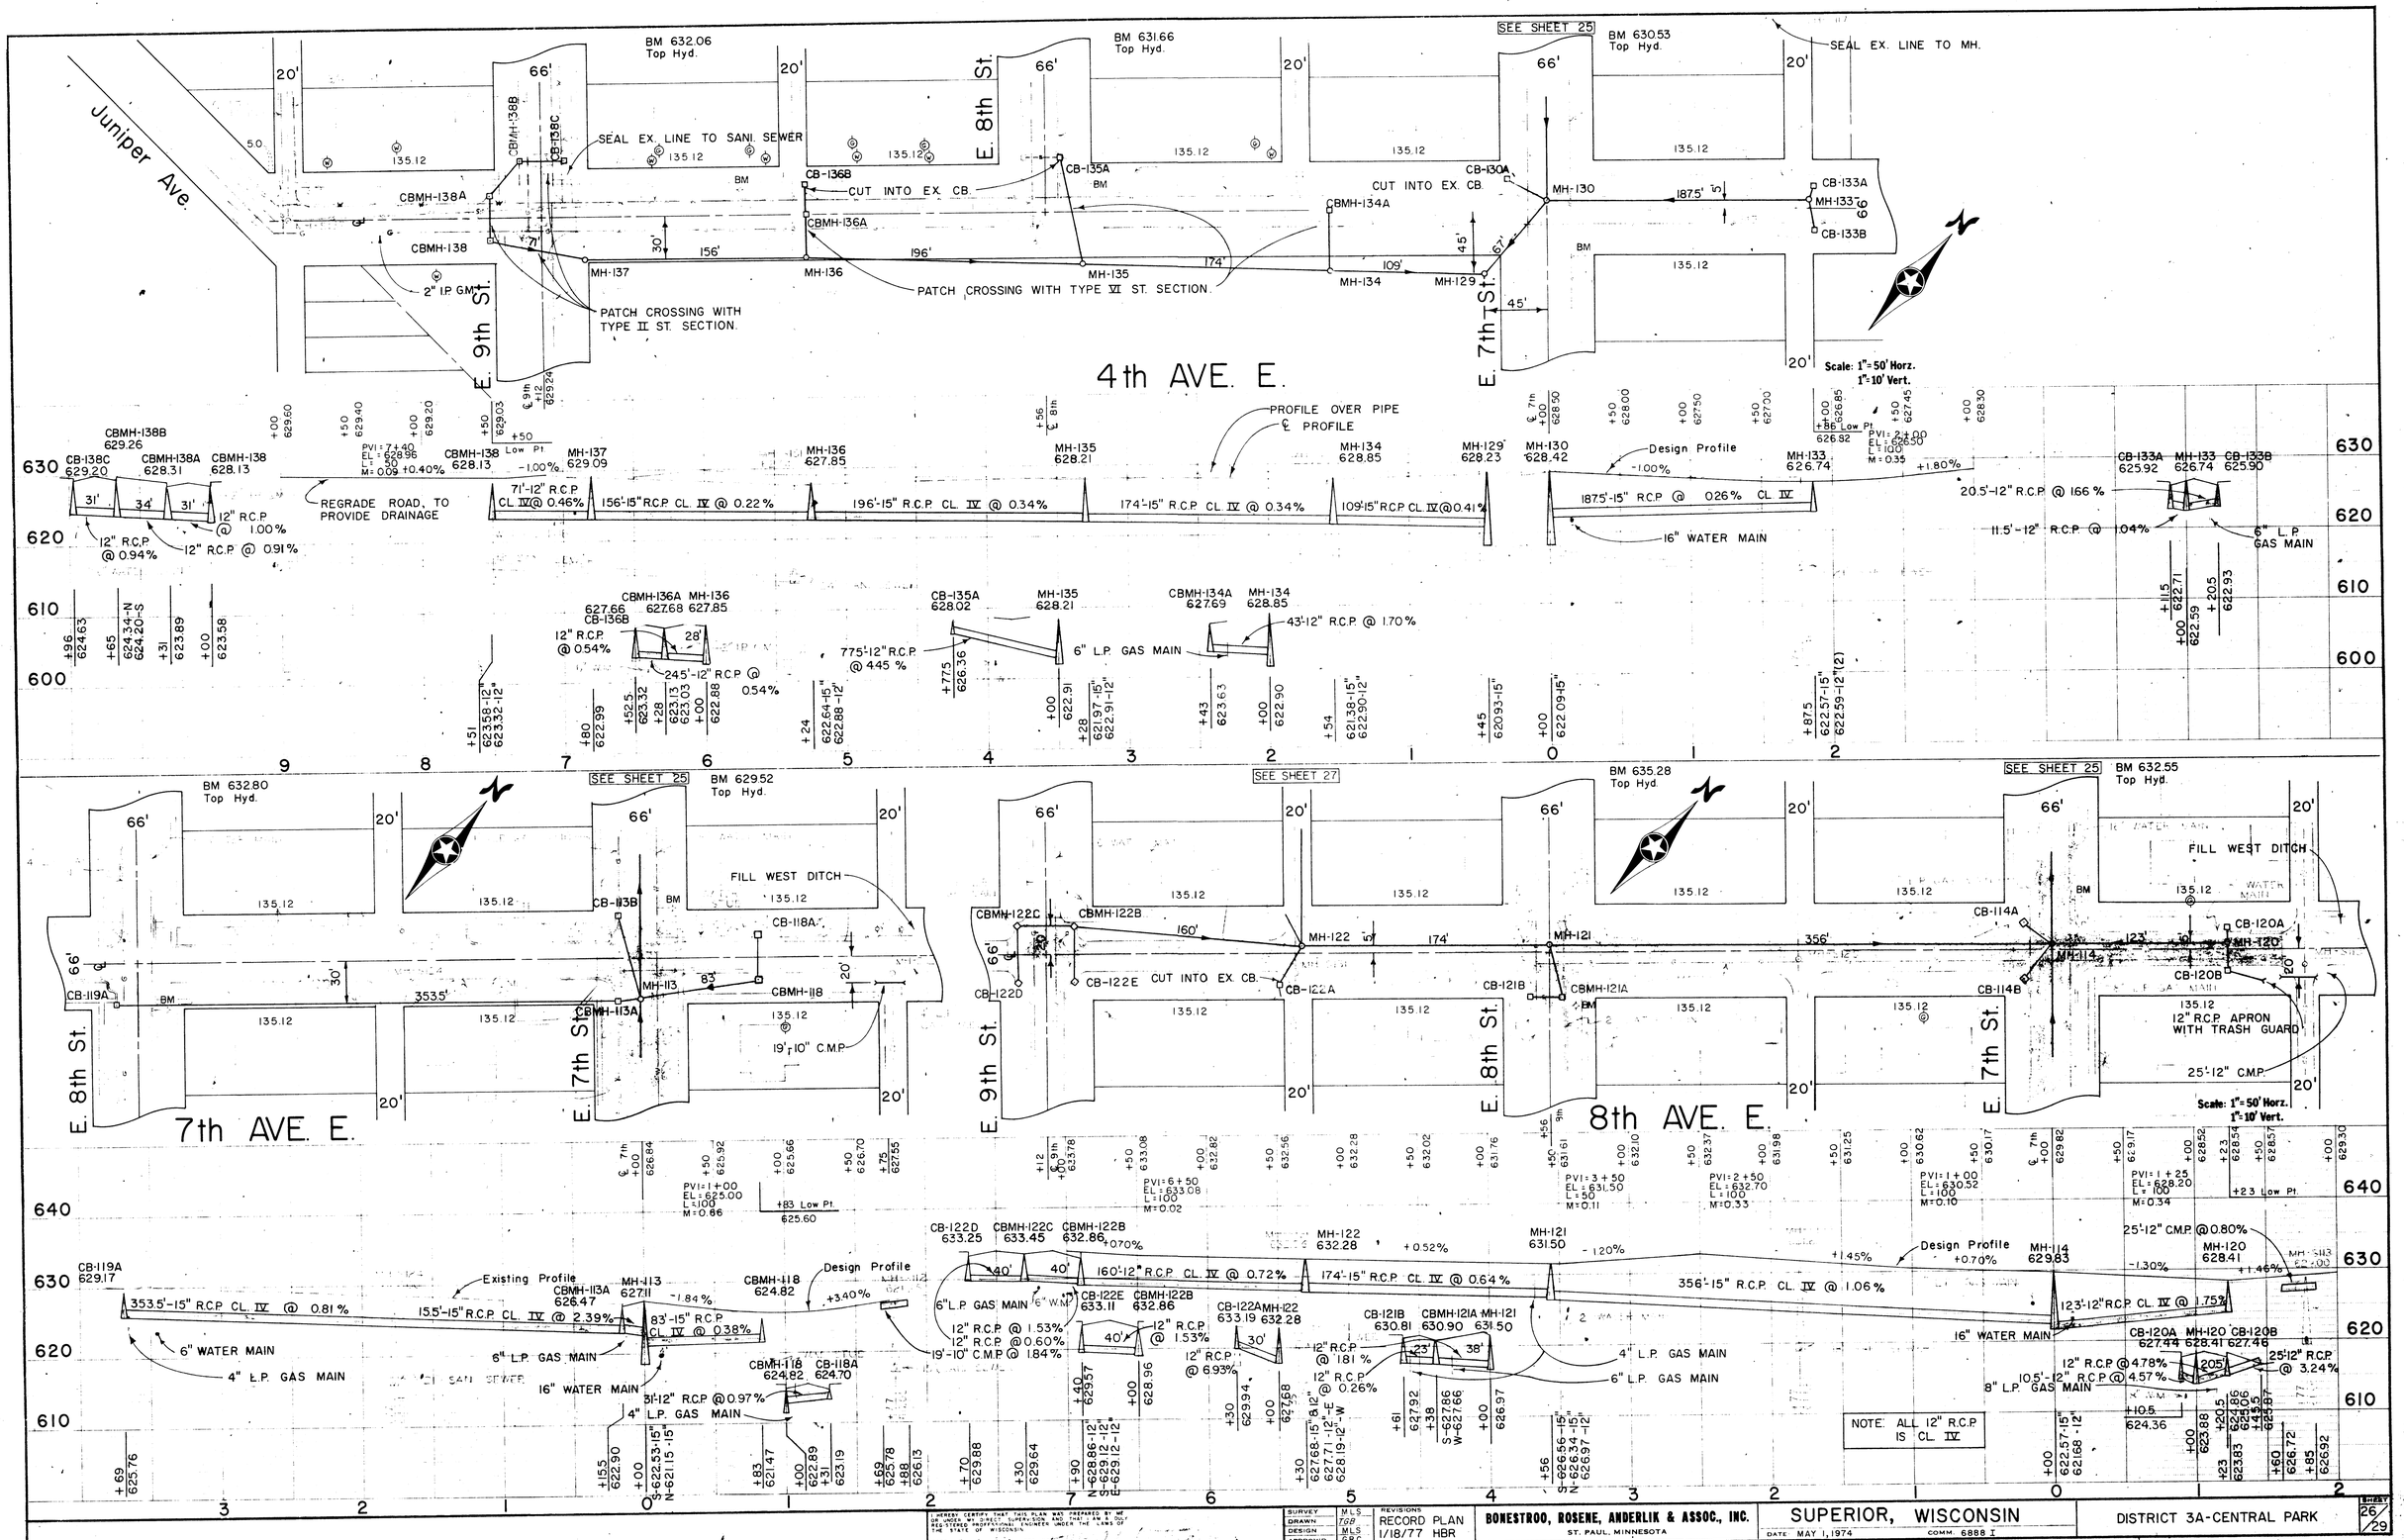

SURVEY	MLS	REVISIONS	BONESTROO, ROSENE, ANDERLIK & ASSOC., INC.	SUPERIOR, WISCONSIN	DISTRICT 3A-CENTRAL PARK
DRAWN	TGB	RECORD PLAN	ST. PAUL, MINNESOTA	DATE MAY 1, 1974 COMM. 6888 I	SHEET 26/29
DESIGN	MLS	1/18/77 HBR			
APPROV'D	GRC				

4th AVE. E. 7th AVE. E. 8th AVE. E.