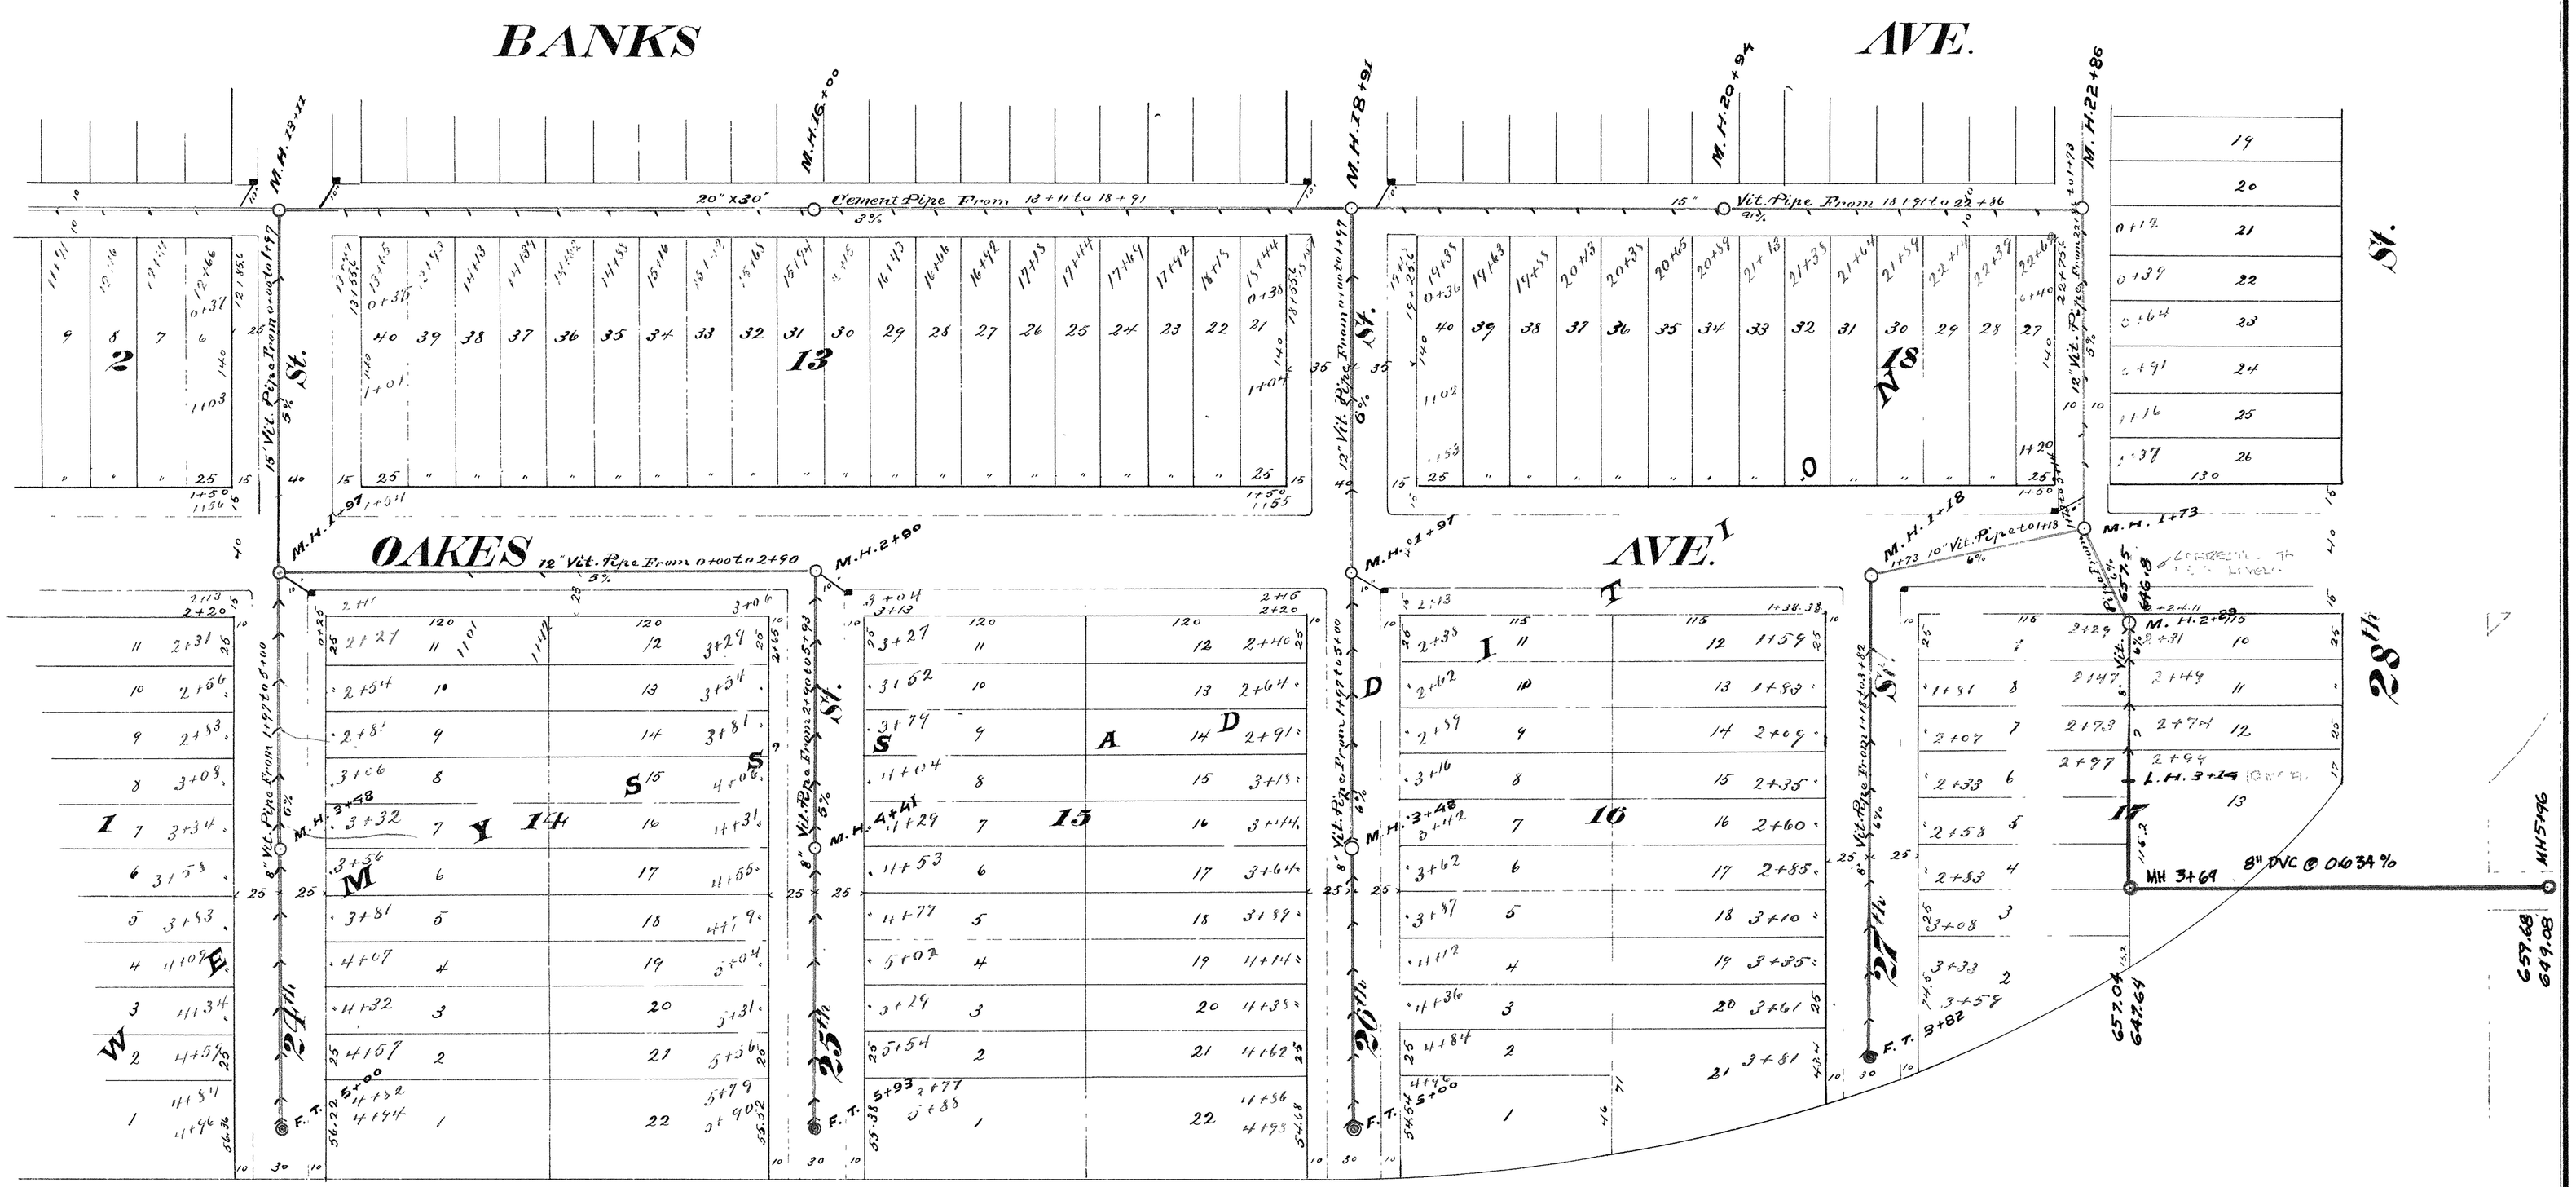

Sewer & Established Street Grades

	M.H. At 1+79		M.H. At 2+90		M.H. At 0+0		Oakes Avenue E. Side		Oakes Avenue W. Side		At F.T.		At L.H.		M.H. At 1+18		M.H. At 1+73	
	Sewer	St.	Sewer	St.	Sewer	St.	Sewer	St.	Sewer	St.	Sewer	St.	Sewer	St.	Sewer	St.	Sewer	St.
27th St.					41.30	54.05	42.05	54.9	42.30	54.9	44.43	55.55						
25th St.									45.13		46.81							
26th St.					43.00	55.84	43.90	56.5	43.32	56.5	46.00	57.15						
27th St.									46.74		43.23							
Alley N. 28th St.					45.08		45.82				46.24		46.78					
Oakes Ave.	43.41	54.5	44.56 43.00	55.23											46.43	56.90	45.91	57.45

CITY OF SUPERIOR

SEWER PLAN

Contract let April 16. 1891
" completed Sept. 14. 1891
Joseph Wolf. Contractor
A. Carlson, F. McKinzie, T. A. King, Insps.
E. B. Banks, City Engineer.

3B-2