

REPLACEMENT COVERS FOR SANITARY M.H.'S

DISTRICT 3B - STREET RESTORATION  
6888J


Manhole Number	Cover Type	Type Seal	Change	Build
MH-S1	III		- 1.08	
MH-S1A	R1642B		16.56	
MH-S2	IV	I		
MH-S3	VI	I		
MH-S4	XV			
MH-S5	XVI	I		
MH-S6	VII	I		
MH-S7	III			
MH-S8	VIII	I		
MH-S9	VIII	I	- 1.05	
MH-S10	VIII			
MH-S11	XVII			
MH-S12	VI			11.63
MH-S13	XVI	I		
MH-S14	XVII	I		
MH-S15	XVII			
MH-S16	XVII			
MH-S17	XVII	I		
MH-S18	XVII	I		
MH-S19	XVII	I		
MH-S20	XVI	I		
MH-S21	XVI	I	- 0.38	
MH-S22	XVI			
MH-S23	VI			
MH-S24	XVI		- 0.17	
MH-S25	VI	I		
MH-S26	XV			
MH-S27	VIII	I		
MH-S28	XVII			
MH-S29	X	I	+ 0.54	
MH-S30	X	I	+ 0.82	
MH-S31	XVI			
MH-S32	XVI			
MH-S33	XVI			
MH-S34	XVI			
MH-S35	I			
MH-S36	I			
MH-S37	I			
MH-S38	XVI			
MH-S39				
MH-S40	XVI			
MH-S41	XVI	I	- 0.60	
MH-S42	XVI			
MH-S43	VIII	I		
MH-S44	VIII			
MH-S45	VIII			
MH-S46	VIII			
MH-S47	VIII	I		
MH-S48	XVI	I		
MH-S49	XVII			
MH-S50	VIII	I		
MH-S51	VIII	I		
MH-S52	XVI			
MH-S53	XVI	I		
MH-S54	XVI	I		
MH-S55	VIII	I		
MH-S56	VIII	I		
MH-S57	XVI	I		
MH-S58	XVI	I		
MH-S59	XVI	I		
MH-S60	XVI	I		
MH-S61	VIII	I		
MH-S62	VIII			
MH-S63	XVI			
MH-S64	VIII	I		
MH-S65	XVI	I	- 0.43	
MH-S66	VI			
MH-S67	VIII	I		
MH-S68	XVI			
MH-S69	XVI	I		
MH-S70	VIII			
MH-S71	XVI			
MH-S72	XVI	I		
MH-S73	XVI	I		
MH-S74	X			
MH-S75	VI			
MH-S76	XVI	I		
MH-S77	XVI	I		
MH-S78	XVI	I		
MH-S79	XVI	I		
MH-S80	VI			
MH-S81	VIII	I		
MH-S82	VIII			
MH-S83	VIII			
MH-S84	VIII			
MH-S85	XVI	I		
MH-S86	XVI	I		
MH-S87	VI	I	- 0.70	
MH-S88	VIII	I	- 0.59	
MH-S89	XVII			
MH-S90	XVI	I	- 0.75	
MH-S91	VI			
MH-S92	VIII			
MH-S93	VI	I	- 0.38	
MH-S94	VI	I		
MH-S95	XVI	I		
MH-S96	XVI	I		
MH-S97	XVI	I		
MH-S98	VI	I	- 1.03	
MH-S99	VI	I		
MH-S100	IV			
MH-S101	XVI		- 0.97	
MH-S102	VIII	I		
MH-S103	XVI	I	- 0.36	
MH-S104	XVI			
MH-S105	XVI			
MH-S106	XVI			
MH-S107	XVI			
MH-S108	XVI			
MH-S109	VI		- 0.80	
MH-S110	XVI	I	- 0.31	
MH-S111	VI	I	- 1.00	
MH-S112	VI	I		
MH-S113	XVI	I		
MH-S114	XVI	I		

TYPE LISTING	Type	Cover	Thickness	No. Replaced
I	III	25 3/4"	2"	4
II	IV	25 1/2"	1 1/2"	2
III	V	24 1/4"	1 1/2"	14
IV	VI	25"	1"	15
V	VII	24"	1"	1
VI	VIII	25 3/8"	1"	30
VII	X	24 3/8"	1"	3
VIII	XII	24 1/2"	1 1/2"	2
IX	XV	24 1/4"	1"	7
X	XVI	25 1/4"	1"	64
XI	XVII	25 1/2"	1"	12

DISTRICT 3B - File No. 6888J - Continued

Manhole Number	Cover Type	Type Seal	Change	Build
MH-S115	VI			
MH-S116	VIII	I		
MH-S117	VIII	I		
MH-S118	XVI			
MH-S119	XVI	I		
MH-S120	XVI	I		
MH-S121	I			
MH-S121A				
MH-S122	XVI	I		
MH-S123	XVI			
MH-S124	XVI			
MH-S125	XVI			
MH-S126	XVI			
MH-S127	IV			
MH-S128	XVI			
MH-S129	XVII			
MH-S130	IV			
MH-S131	XII			
MH-S132	VIII			
MH-S133	IV			
MH-S134	IV			
MH-S135	IV			
MH-S136	IV			
MH-S137	IV			
MH-S138	IV			
MH-S139	IV			
MH-S140	IV			
MH-S141	XV			
MH-S142	XV			
MH-S143	XV			
MH-S163	XVI	I	- 0.24	
MH-S164	XVI			
MH-S165	XVII			
MH-S166	XVI			
MH-S167	XVI	I		
MH-S168	XV			
MH-S169	XVI	I		
MH-S170	VIII			

STANDARD CATCHBASIN LOCATION FOR CATCHBASINS NOT DIMENSIONED SCALE: 1"=50'

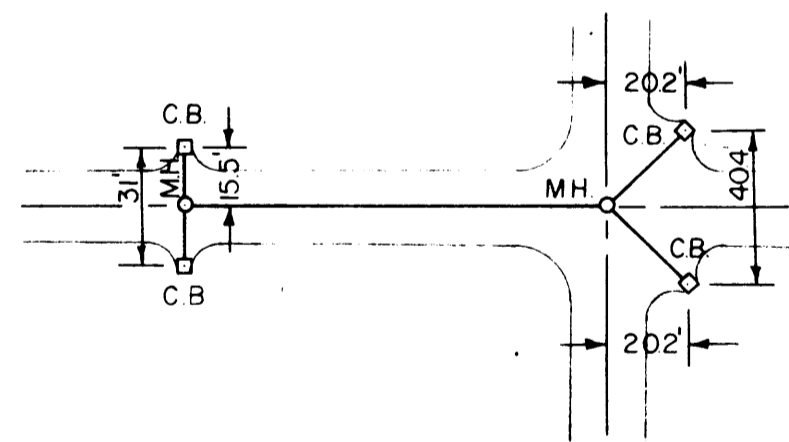

LEGEND FOR PLANS

EXISTING	PROPOSED
STORM SEWER	— — — — —
SANITARY SEWER	— — — — —
WATER MAIN	— — — — —
GAS MAIN	— — — — —
WATER SERVICE	— — — — —
GAS SERVICE	— — — — —
MANHOLE - STORM	○ MH-SI
MANHOLE - SANITARY	○ MH-SI
CATCHBASIN	□ CB-IA
APRON	— — — — —
RAILROAD	— — — — —
TREES	* * * * *
POWER POLE	— — — — —
FENCE	— — — — —
CENTERLINE	— — — — —
CULVERT	— — — — —

Sheet No.	Street	From	To	Length	Width	Replacement Section	Curb Length	Curb Type	Street Type	Notes
5	Fischer Ave.	Faxon St. (0+10)	22nd St. (2+95)	285'	20'	Type I	570'	A	Plate 5-51	x 20'
6	N. 23rd St.	Lamborn (7+30)	Hammond (18+32)	1102'	20'	Type I	2204'	A	Plate 5-51	x 20'
6	Alley No. 23rd & W. Hammond	23rd St. (0+10)	Faxon St. (3+11)	301'	15'	Type I	---	---	Complete	---
7	Clough Ave.	Faxon St. (0+09)	N. 22nd St. (2+94)	285'	20'	Type I	570'	A	late 5-51	x 20'
7	Clough Ave.	N. 22nd St. (3+64)	N. 21st St. (6+32)	268'	20'	Type I	536'	A	late 5-51	x 20'
7	23rd St.	Oakes Ave. (5+73)	Butler Ave. (3+73)	203'	20'	Type I	406'	A	late 5-51	x 20'
7	Cumming Ave.	N. 23rd St. (0+10)	N. 24th St. (3+98)	388'	20'	Type I	776'	A	late 5-51	x 20'
7	24th St.	Cumming Ave. (0+10)	Hammond Ave. (3+42)	332'	20'	Type I	664'	A	late 5-51	x 20'
8	N. 23rd St.	Hammond Ave. (14+65)	Hughitt Ave. (30+9)	321'	12'	Type I	---	---	Type A	x 26'
8	N. 23rd St.	Hughitt Ave. (14+65)	Ogden Ave. (30+9)	309'	12'	Type I	---	---	Type A	x 26'
8	N. 23rd St.	John Ave. (11+54)	Tower Ave. (13+00)	146'	26'	Type I	292'	A	late 5-51	x 26'
9	N. 22nd St.	Hammond Ave. (0+42)	Hughitt Ave. (3+50)	308'	20'	Type I	616'	A	late 5-51	x 20'
9	N. 22nd St.	Hughitt Ave. (4+17)	John Ave. (7+25)	308'	14'	Type I	308'	Integral	Type B	x 24'
9	N. 22nd St.	John Ave. (7+85)	Tower Ave. (14+65)	680'	13.5'	Type I	642'	Integral	Type C	x 24'
9	N. 22nd St.	Tower Ave. (15+51)	Banks Ave. (18+61)	310'	20'	Type I	620'	A	late 5-51	x 20'
9	N. 22nd St.	Banks Ave. (19+08)	Oakes Ave. (22+34)	326'	20'	Type I	652'	A	late 5-51	x 20'
9	N. 22nd St.	Oakes Ave. (23+04)	Butler Ave. (24+68)	164'	20'	Type I	328'	A	late 5-51	x 20'
11	Butler Ave.	N. 22nd Ave. (0+36)	N. 21st St. (6+38)	474'	20'	Type I	948'	A	late 5-51	x 20'
12	N. 24th St.	Hammond Ave. (0+42)	Hughitt Ave. (3+58)	316'	14'	Type I	316'	Integral	Type D	x 30'
12	N. 24th St.	Hughitt Ave. (4+17)	John Ave. (7+25)	308'	14'	Type I	308'	Integral	Type D	x 30'
12	N. 24th St.	John Ave. (7+85)	Ogden Ave. (10+94)	309'	14'	Type I	309'	Integral	Type D	x 24'
12	N. 24th St.	Ogden Ave. (11+57)	Tower Ave. (14+68)	311'	15'	Type I	311'	Integral	Type D	x 24'
12	N. 24th St.	Tower Ave. (15+57)	Banks Ave. (18+65)	315'	20'	Type I	630'	A	late 5-51	x 20'
12	N. 24th St.	Banks Ave. (19+25)	Oakes Ave. (22+34)	309'	20'	Type I	618'	A	late 5-51	x 20'
12	N. 23rd St.	Banks Ave. (0+34)	Tower Ave. (3+37)	303'	20'	Type I	606'	A	late 5-51	x 20'
14	N. 26th St.	Hughitt Ave. (0+00)	Hammond Ave. (3+43)	343'	12.5'	Type IV	343'	Integral	Type E	---
14	N. 26th St.	John Ave. (0+00)	Ogden Ave. (3+50)	340'	12'	Type IV	340'	Integral	Type E	---
15	N. 26th St.	Oakes Ave. (0+30)	Banks Ave. (3+50)	320'	20'	Type I	640'	A	late 5-51	x 20'
15	N. 26th St.	Banks Ave. (4+05)	Tower Ave. (5+68)	163'	24'	Type I	326'	A	Type F	x 35' x 20'
15	N. 26th St.	Hughitt Ave. (0+00)	John Ave. (3+45)	345'	12.5'	Type IV	345'	Integral	Type E	---
16	Fisher Ave.	Lincoln (0+56)	N. 21st St. (3+00)	356'	20'	Type I	712'	A	late 5-51	x 20'
16	Fisher Ave.	N. 21st St. (3+00)	N. 22nd St. (6+05)	265'	20'	Type I	530'	A	late 5-51	x 20'
17	Lincoln St.	Catlin Ave. (0+20)	Fisher Ave. (4+06)	386'	10'	Type I	772'	Integral	Type G	---
17	Lincoln St.	Fisher Ave. (4+06)	Lamborn Ave. (14+30)	1074'	11'	Type IV	2148'	Integral	Type G	---
17	Lincoln St.	Lamborn Ave. (14+80)	N. 21st St. (18+11)	331'	15.5'	Type IV	331'	Integral	Type G	---
18	Catlin Ave.	N. 21st St. (0+0)	N. 22nd St. (1+80)	180'	10'	Type V	180'	Integral	Type H	x 43'
18	Clough Ave.	Lincoln (0+34)	N. 21st St. (3+00)	266'	20'	Type I	532'	A	late 5-51	x 20'
18	Grand Ave.	N. 22nd St. (0+41)	N. 21st St. (3+28)	369'	20'	Type I	738'	A	late 5-51	x 20'
19	Weeks Ave.	Lincoln St. (0+30)	N. 21st St. (3+18)	288'	2'	Type I	---	---	Type I	x 20'
20	Baxter Ave.	N. 22nd St. (6+9)	Faxon St. (5+6)	266'	20'	Type I	532'	---	---	x 20'
20	Baxter Ave.	N. 21st St. (3+66)	N. 22nd St. (6+26)	260'	20'	Type I	520'	---	---	x 20'
20	N. 22nd St.	Baxter Ave. (0+30)	Hammond Ave. (+13)	683'	20'	Type I	1366'	A	late 5-51	x 20'
20	Cumming Ave.	N. 22nd St. (0+00)	Faxon St. (3+12)	312'	20'	Type I	624'	A	late 5-51	x 20'
20	Baxter Ave.	Lincoln St. (0+20)	N. 21st St. (3+00)	280'	5'	Type I	560'	A	late 5-51	x 24'
21	Faxon St.	Baxter Ave. (0+00)	Cumming Ave. (5+40)	540'	20'	Type I	1080'	A	late 5-51	---
18	Butler Ave.	N. 23rd St. (0+43)	N. 24th St. (3+99)	442'	20'	Type I	884'	A	late 5-51	---
20	Cumming Ave.	N. 21st St. (1+90)	N. 22nd St. (0+00)	190'	20'	Type I	380'	A	late 5-51	x 20'
6	Lamborn Ave.	N. 23rd St. (0+10)	Faxon St. (1+00)	90'	20'	Type I	180'	A	late 5-51	x 20'
7	23rd St.	Oakes Ave. (0+34)	Butler Ave. (2+20)	166'	20'	Type I	332'	A	late 5-51	x 20'

