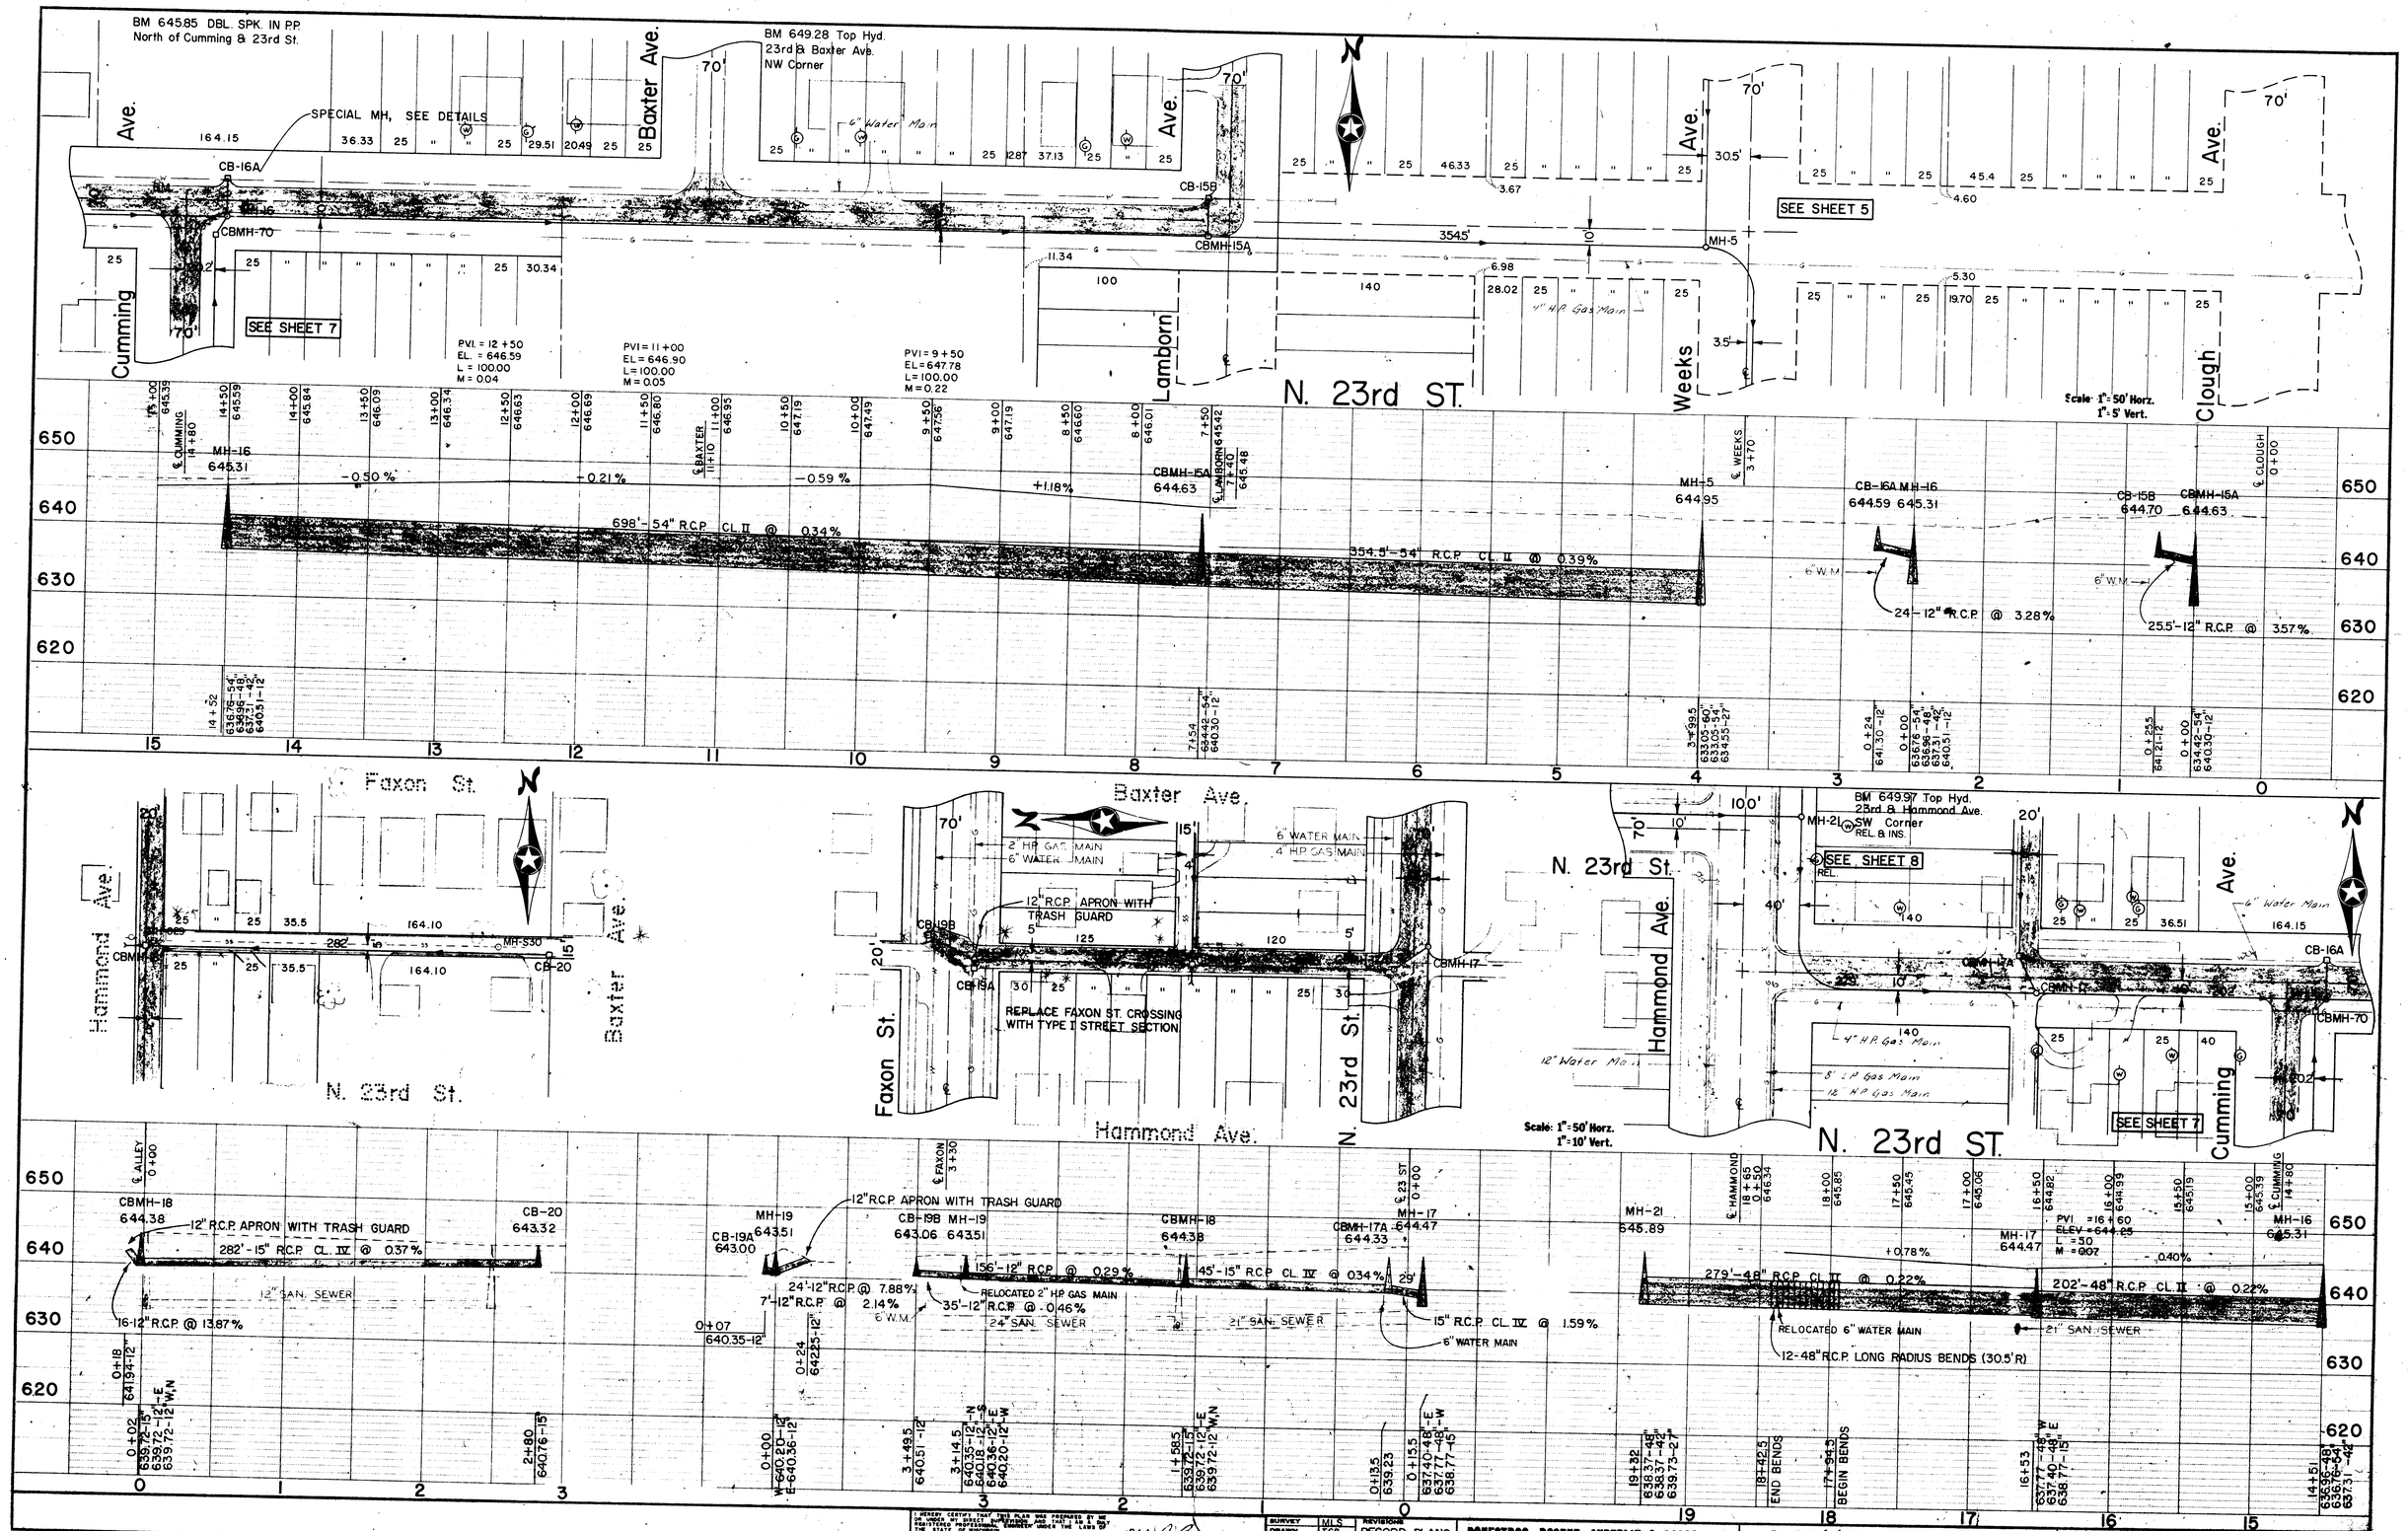

I HEREBY CERTIFY THAT THIS PLAN WAS PREPARED BY ME OR UNDER MY DIRECT SUPERVISION AND THAT I AM A DULY REGISTERED PROFESSIONAL ENGINEER UNDER THE LAWS OF THE STATE OF WISCONSIN.

DATE OCT. 10, 1974 REG. NO. E06589

SURVEY	MLS
DRAWN	TGG
DESIGN	DCB
APPROV'D	GRC

REVISIONS: RECORD PLANS 7/7/78 HBR

BONESTROO, ROSENE, ANDERLIK & ASSOC., INC. ST. PAUL, MINNESOTA

SUPERIOR, WISCONSIN

DATE: SEPT. 30, 1974 COMM. 6888J

DISTRICT 3B FAXON STORM SEWER SEPARATION

6 / 21

23rd St.
Alley North 23rd St.