




# 1313 Belknap St

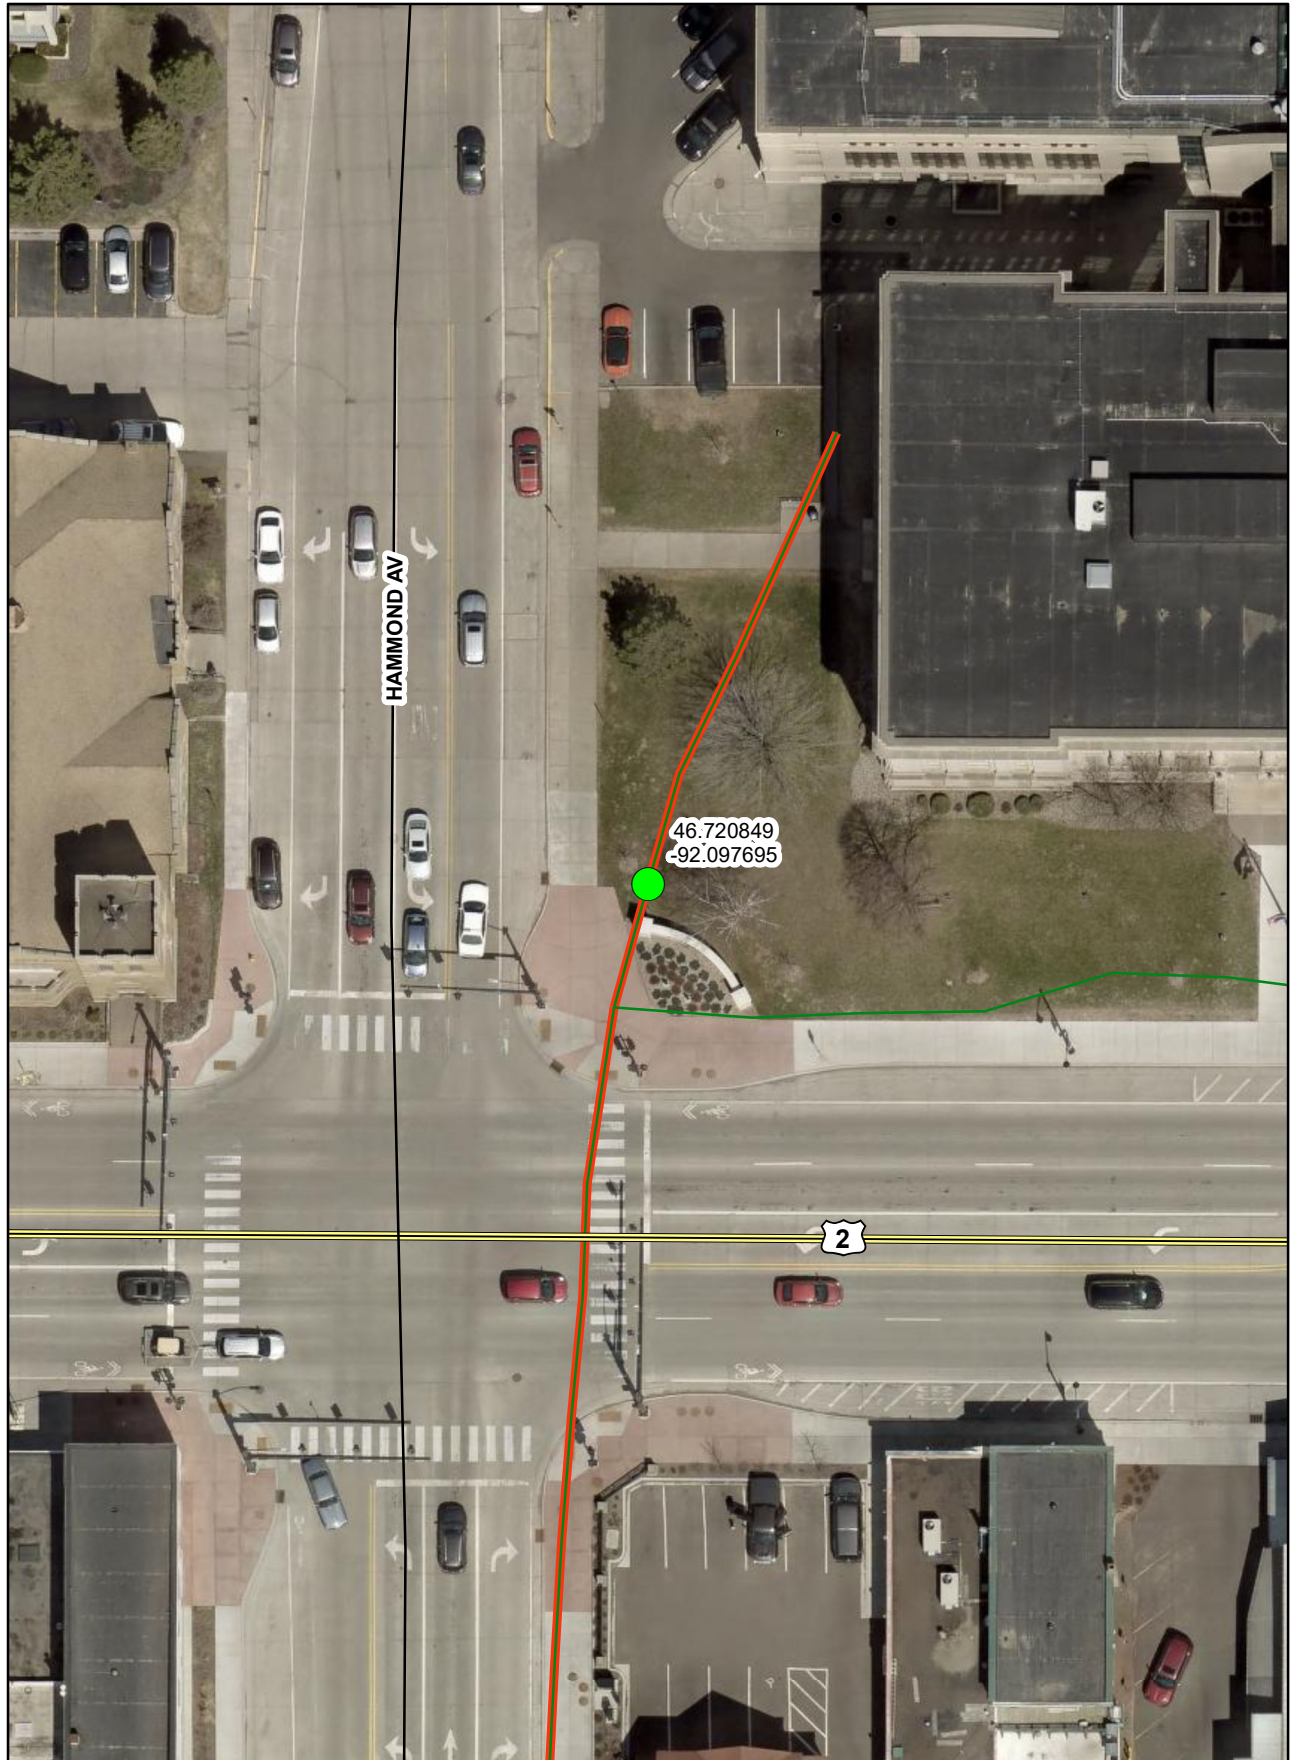


# 1800 Hammond Ave

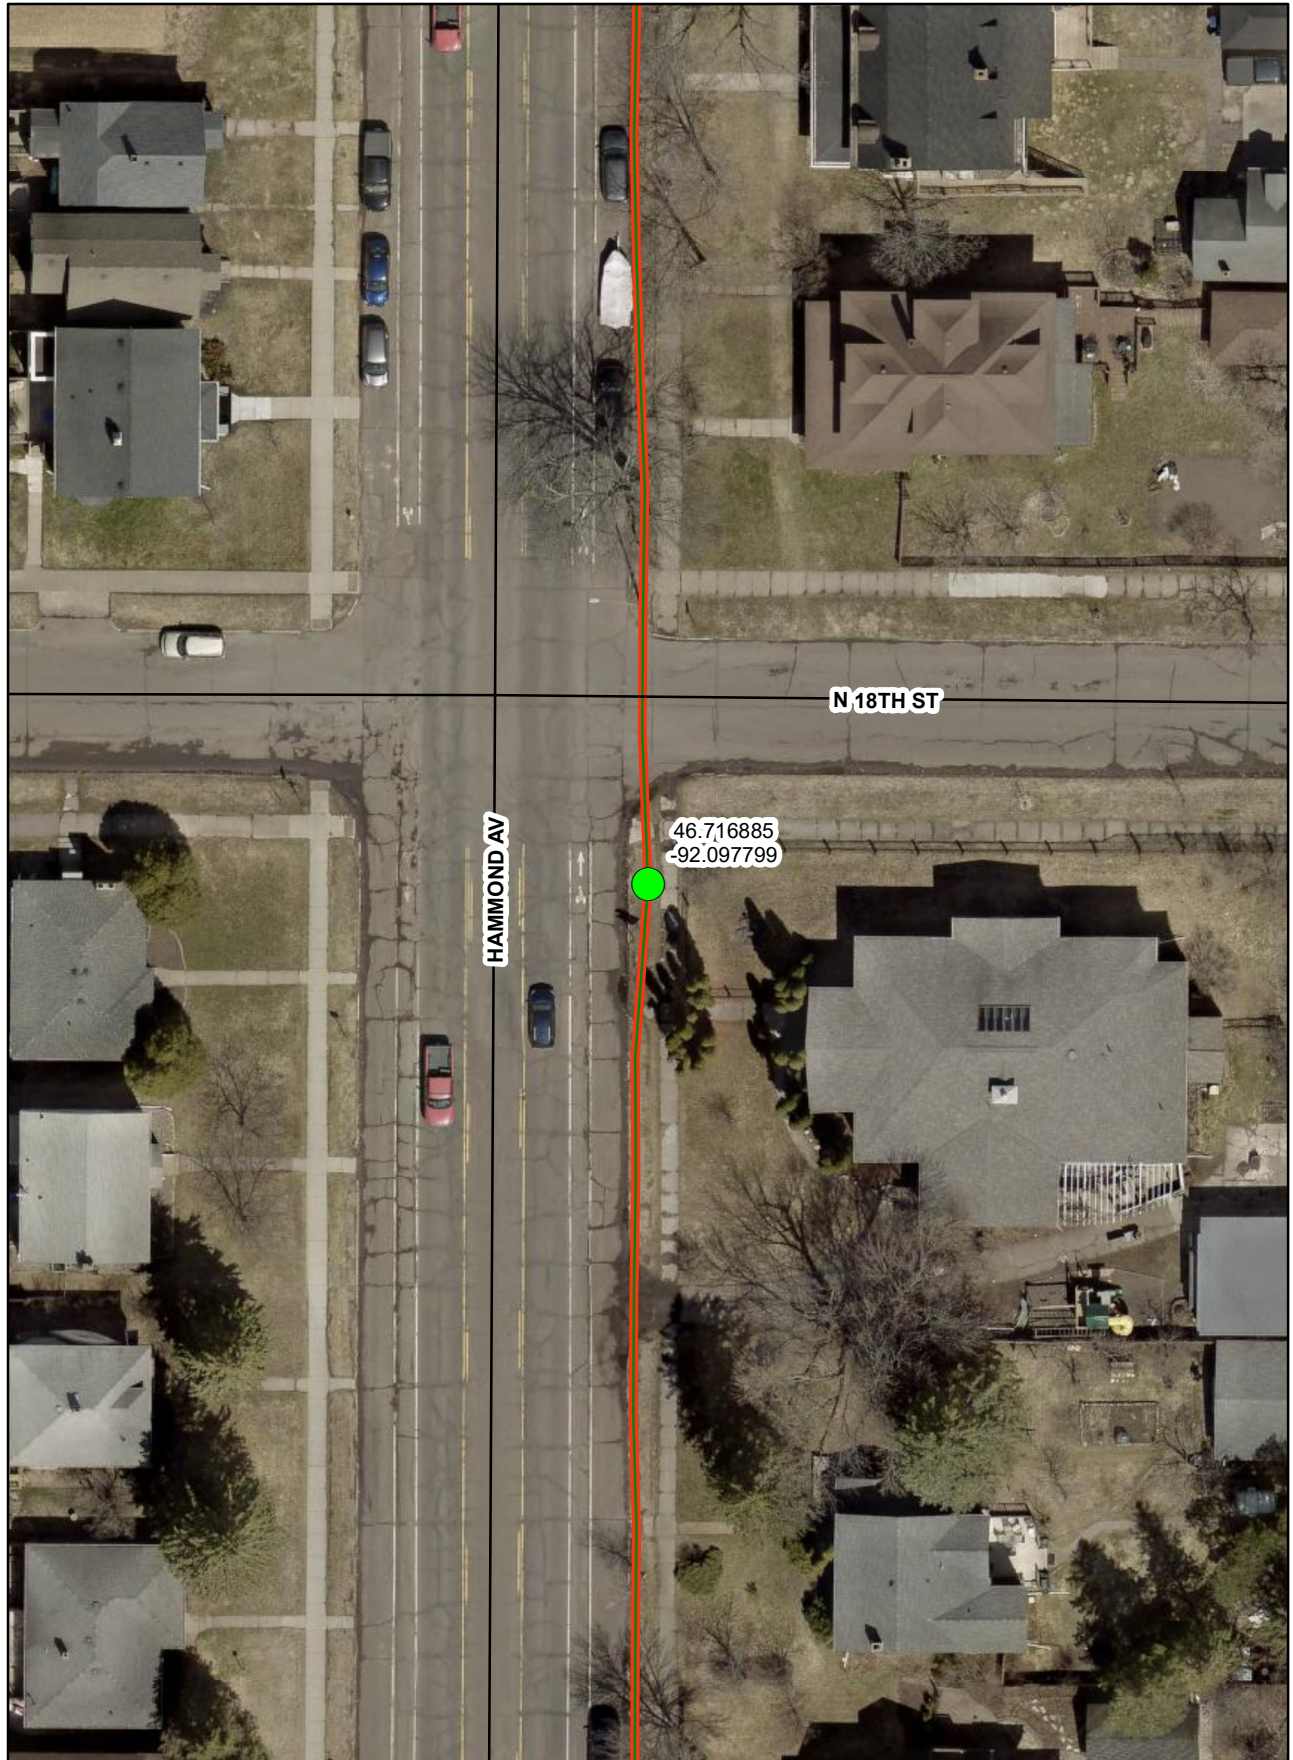


# 2100 Hammond Ave

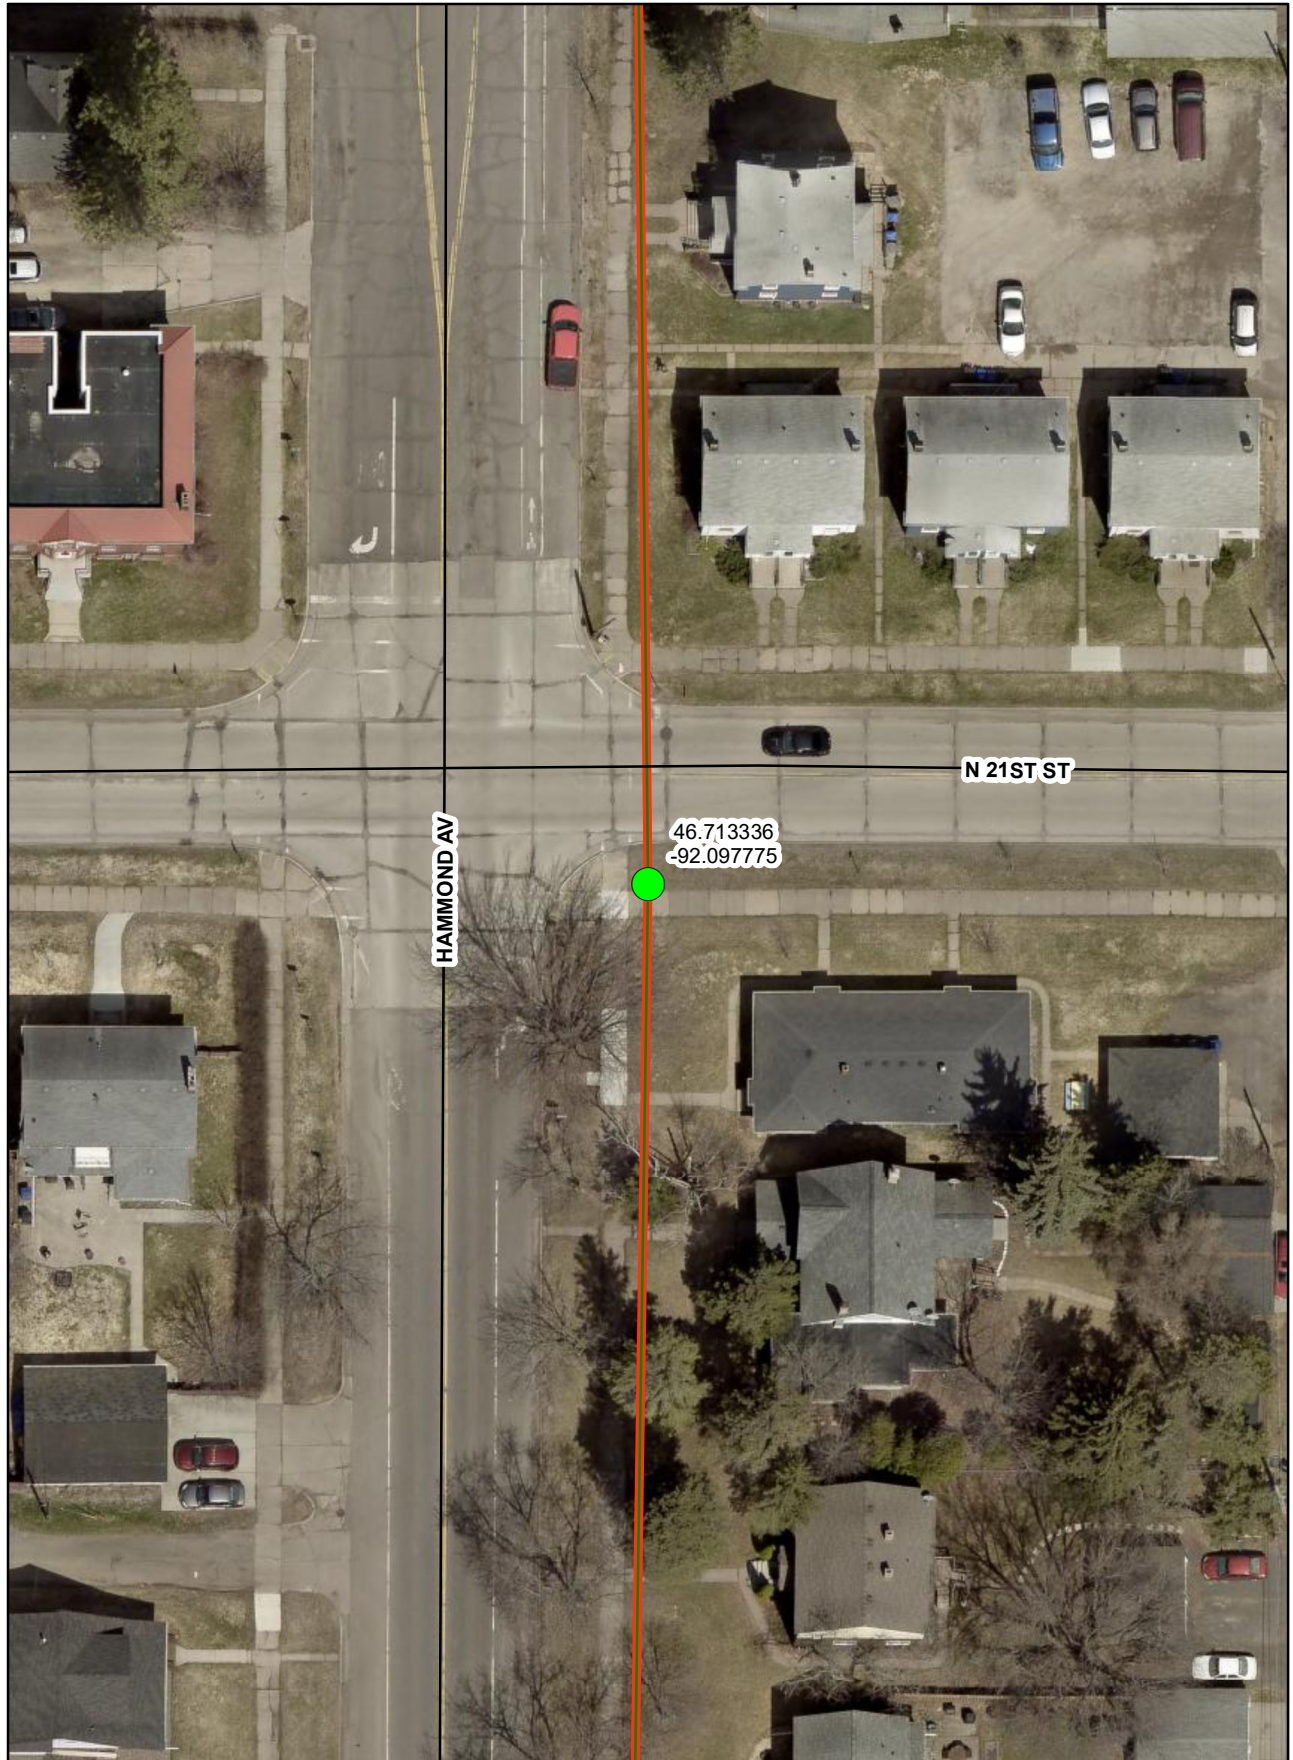


# 2331 Hammond Ave

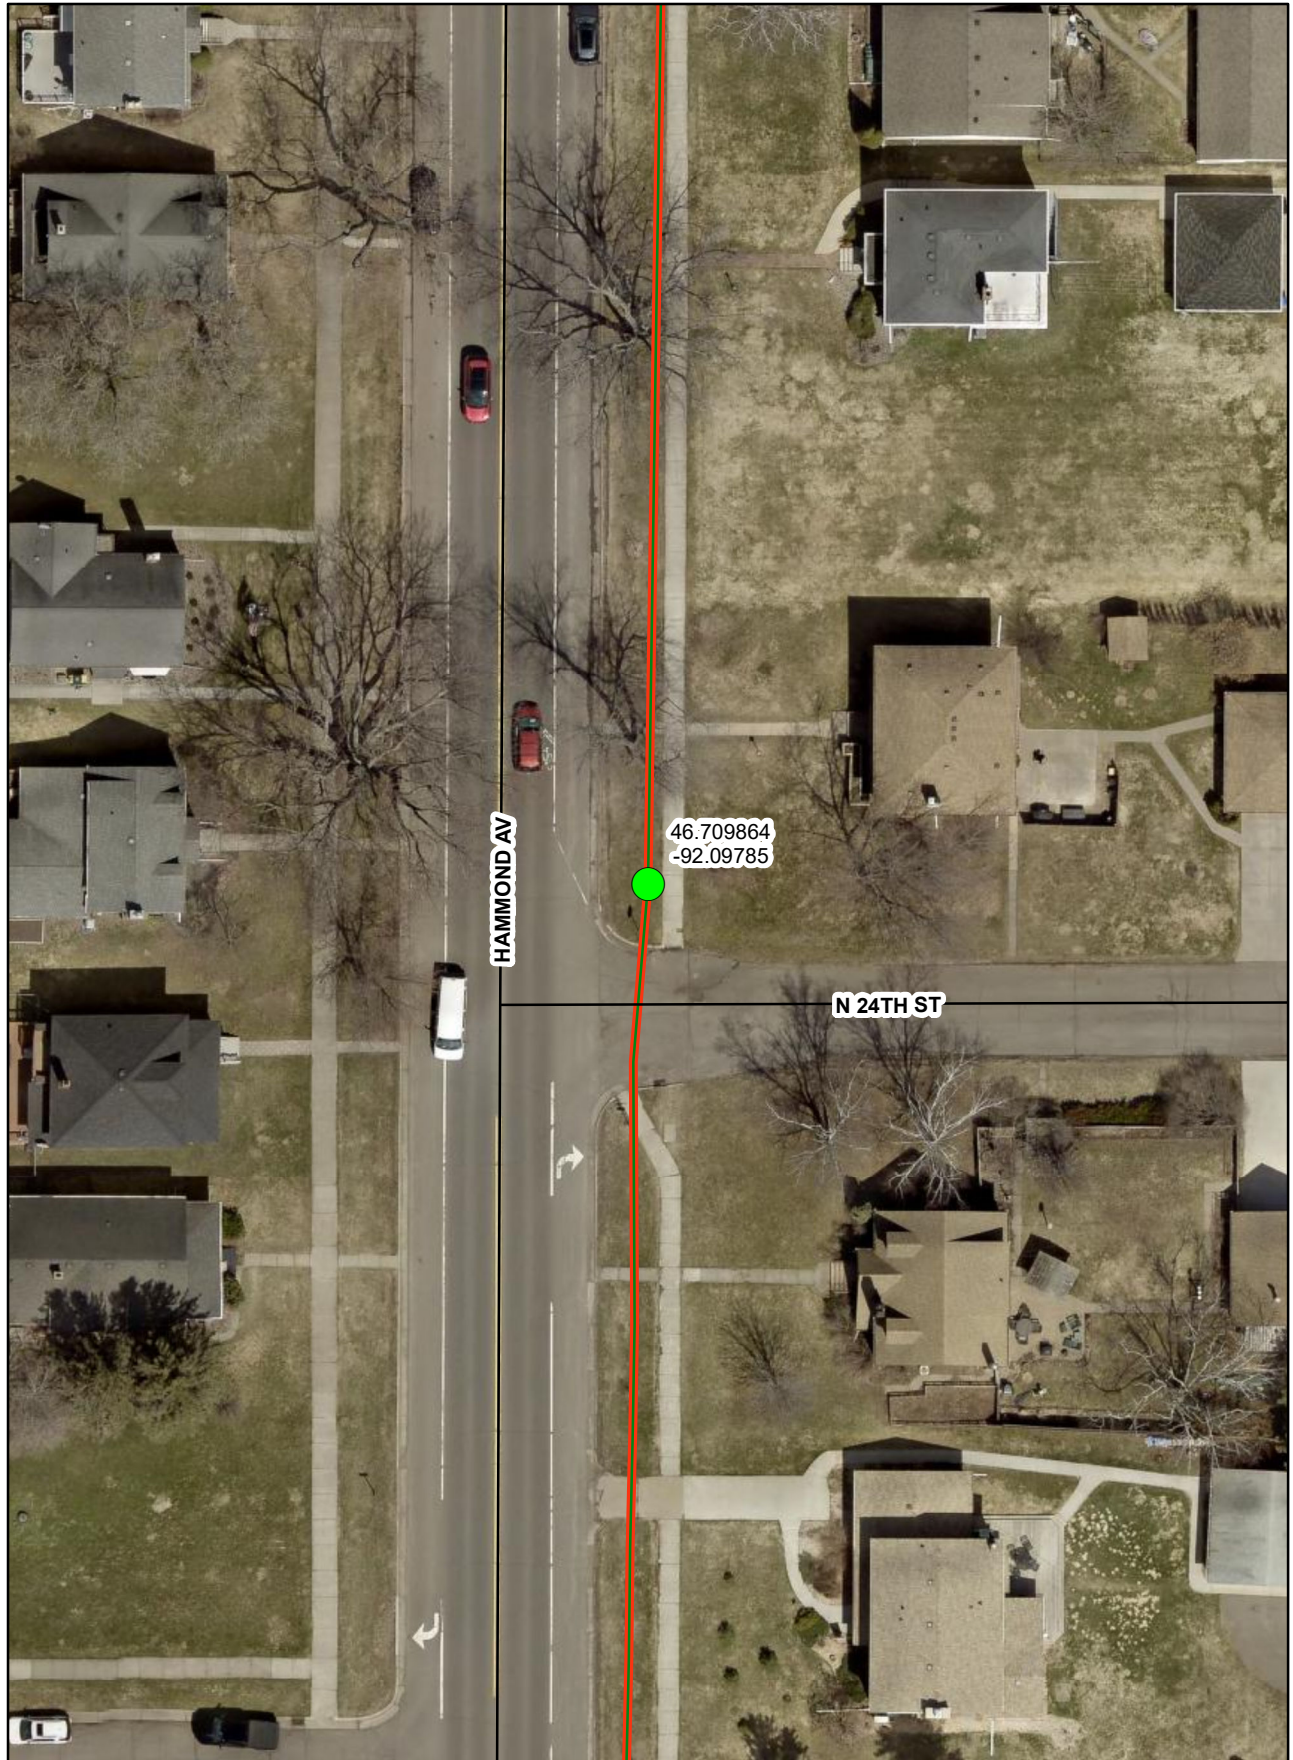


# 2800 Hammond Ave

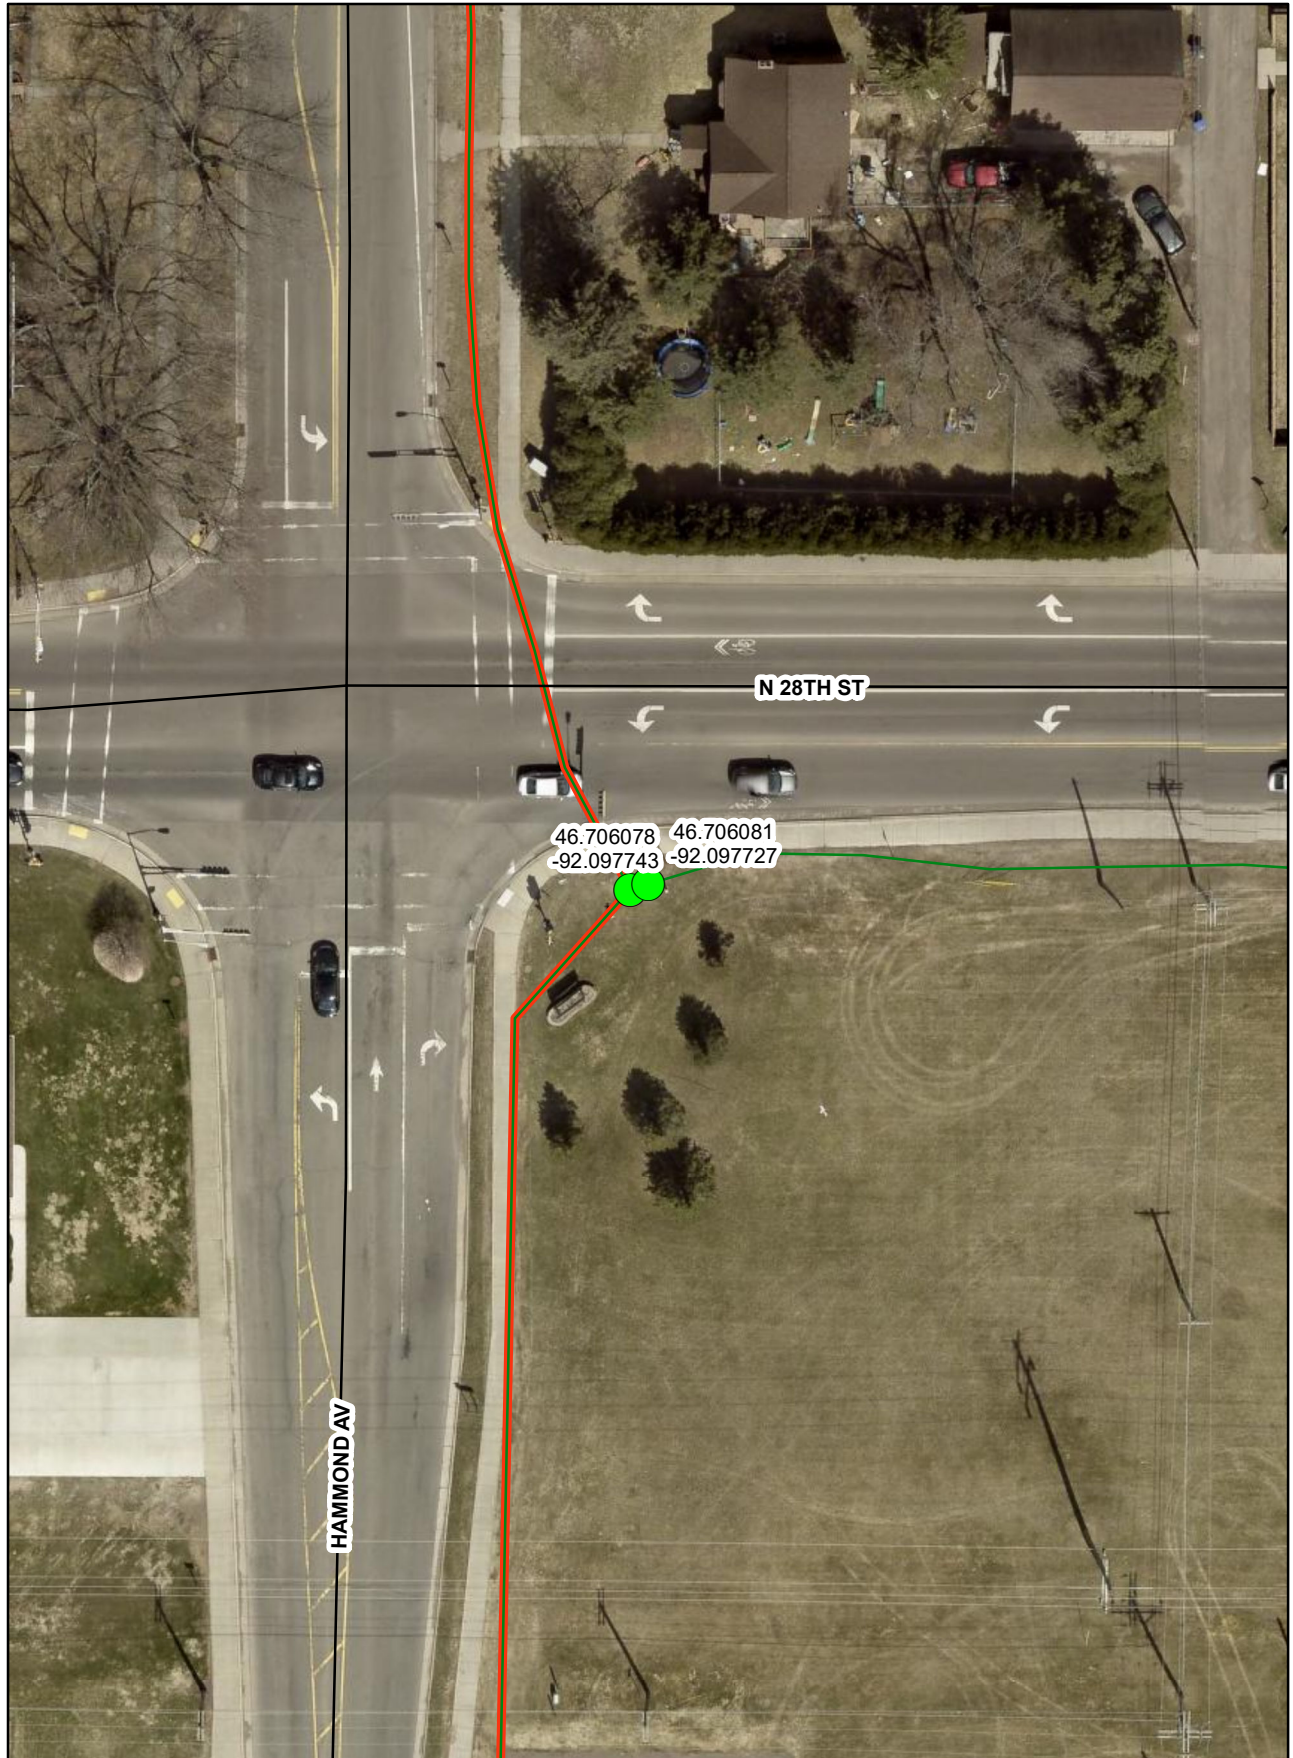

# 2800 Hammond Ave

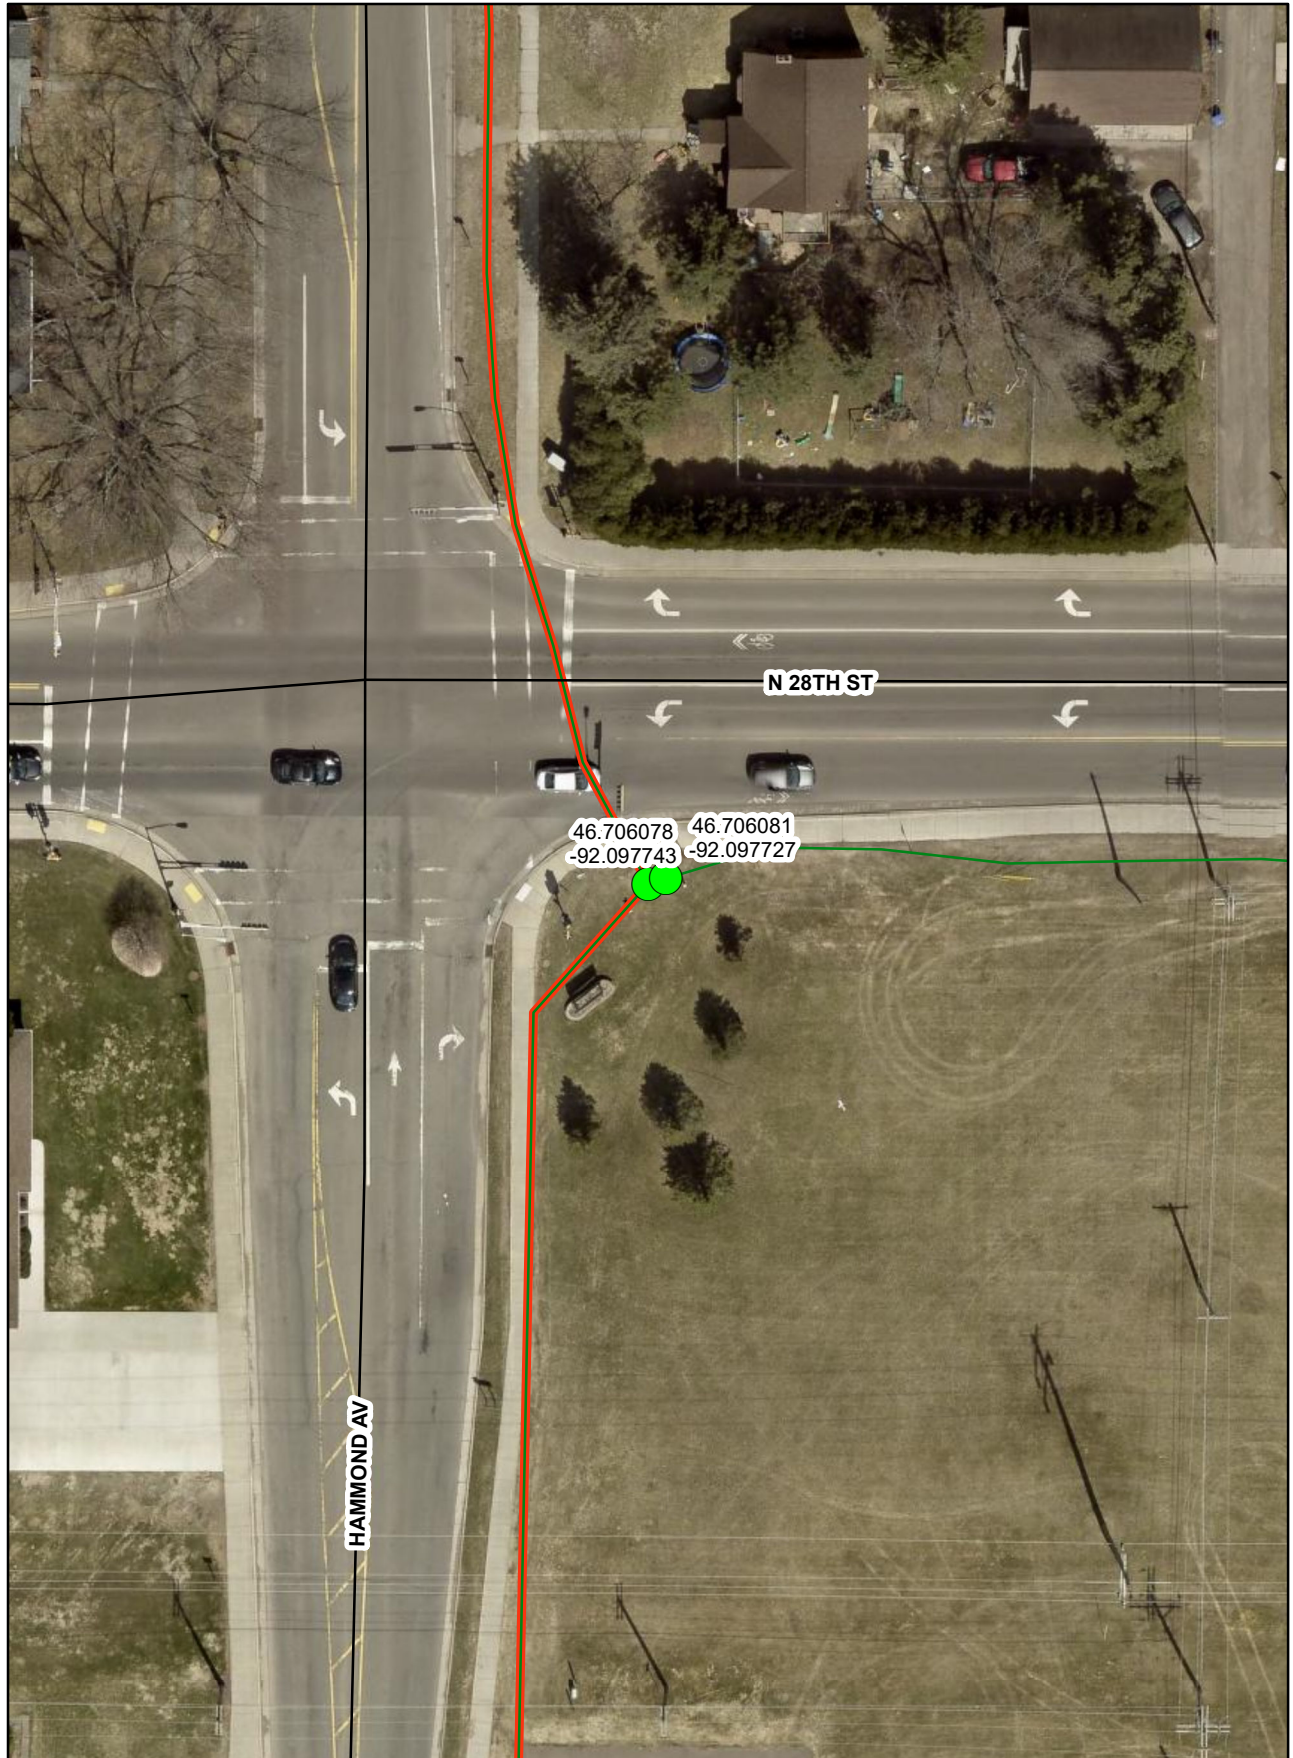

# 3100 Hammond Ave

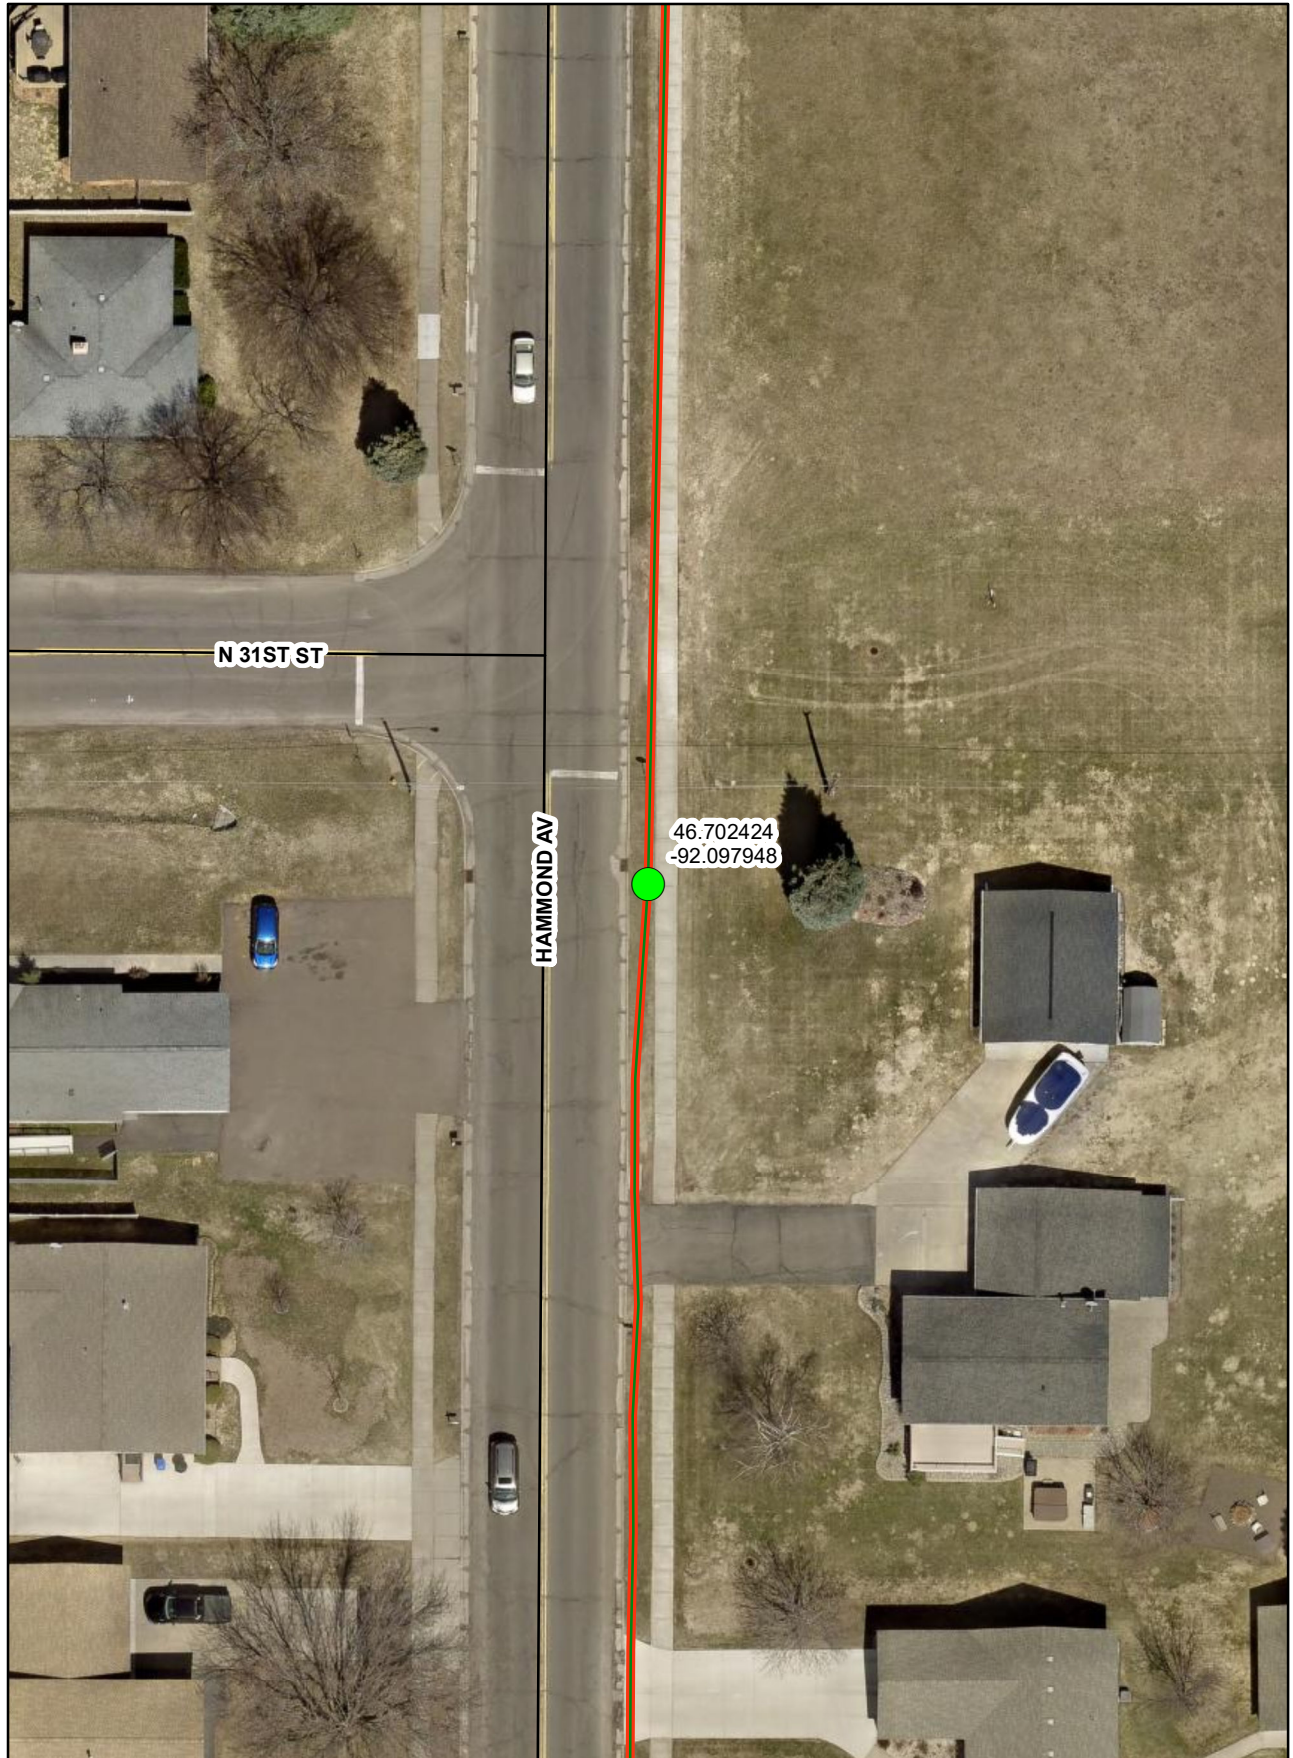


N 31ST ST

HAMMOND AV


46.702424  
-92.097948

# 3400 Hammond Ave

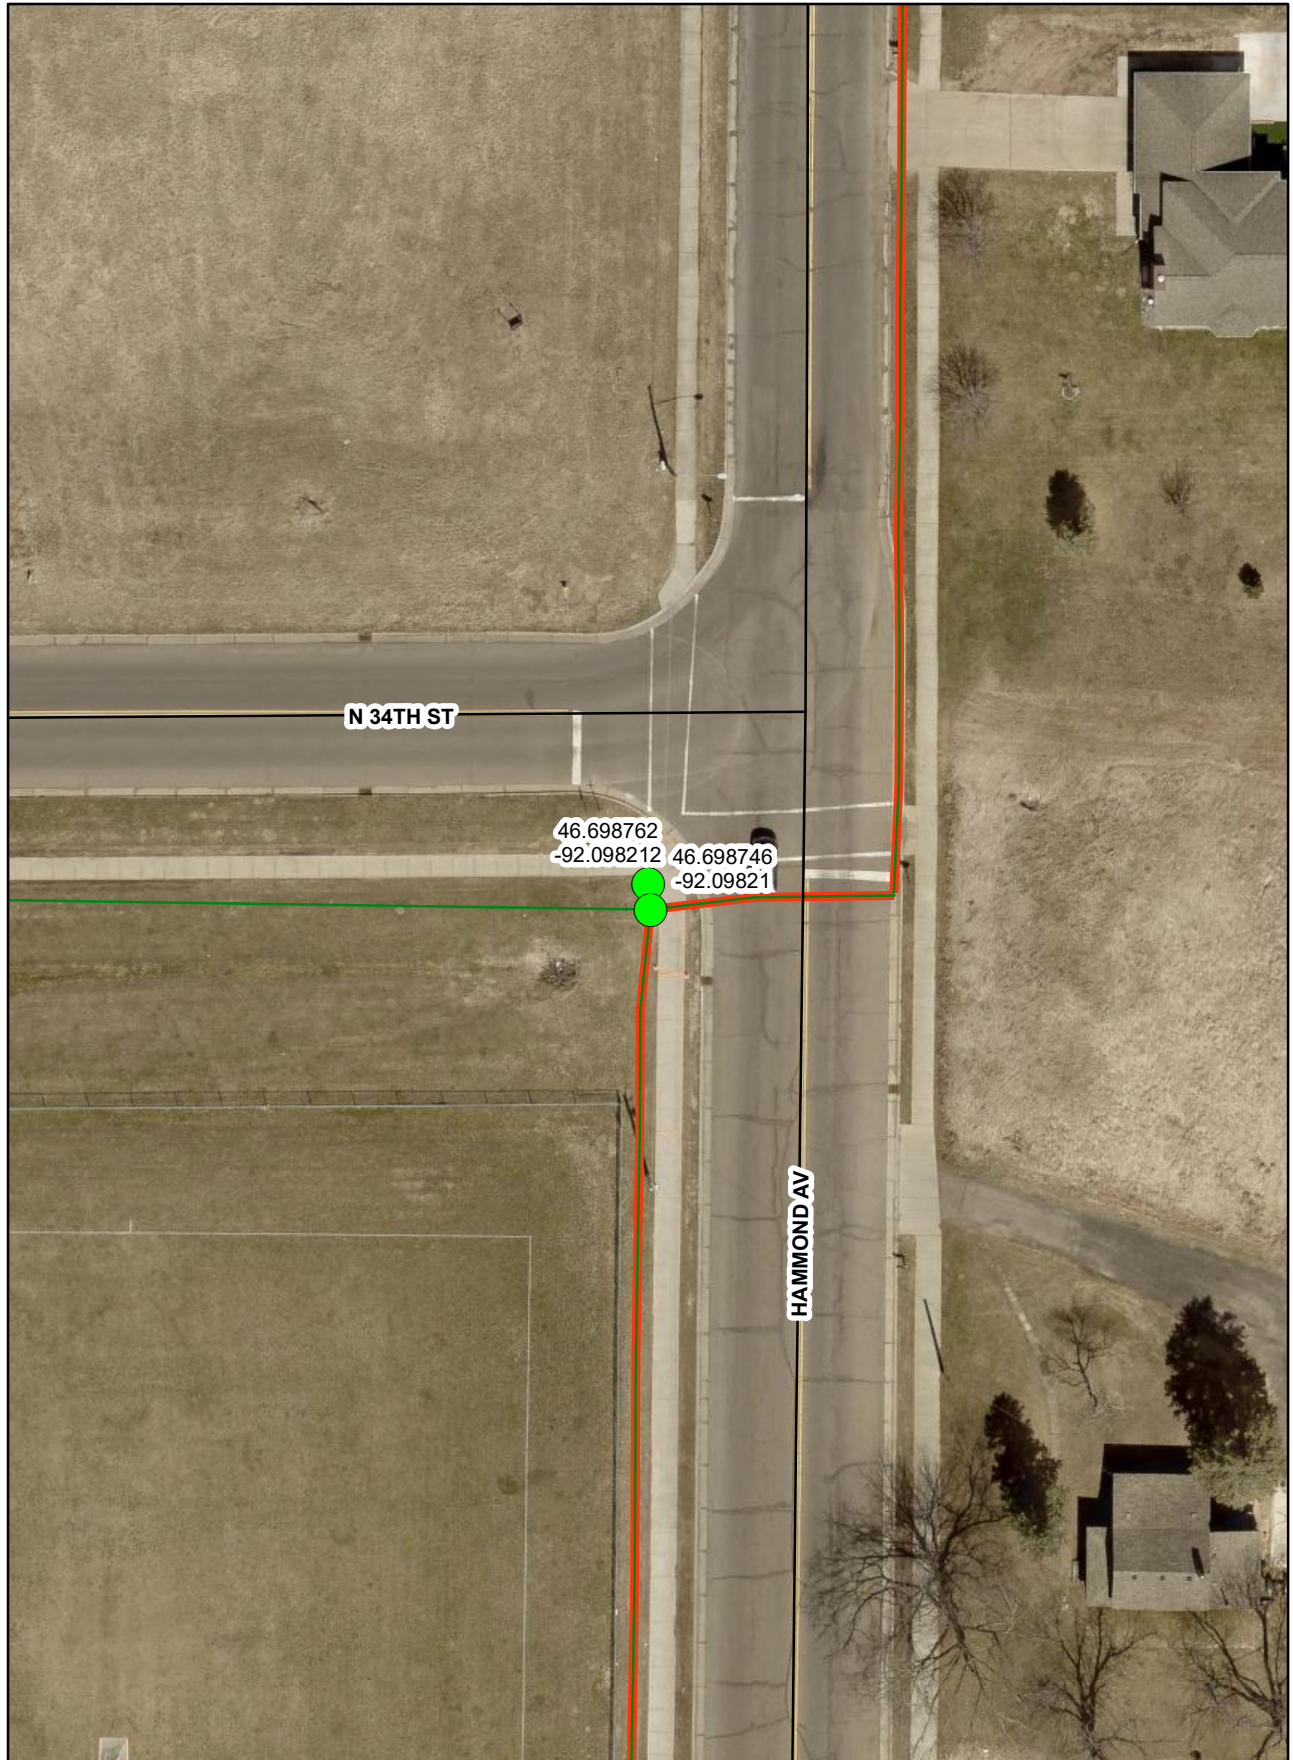




# 3400 Hammond Ave

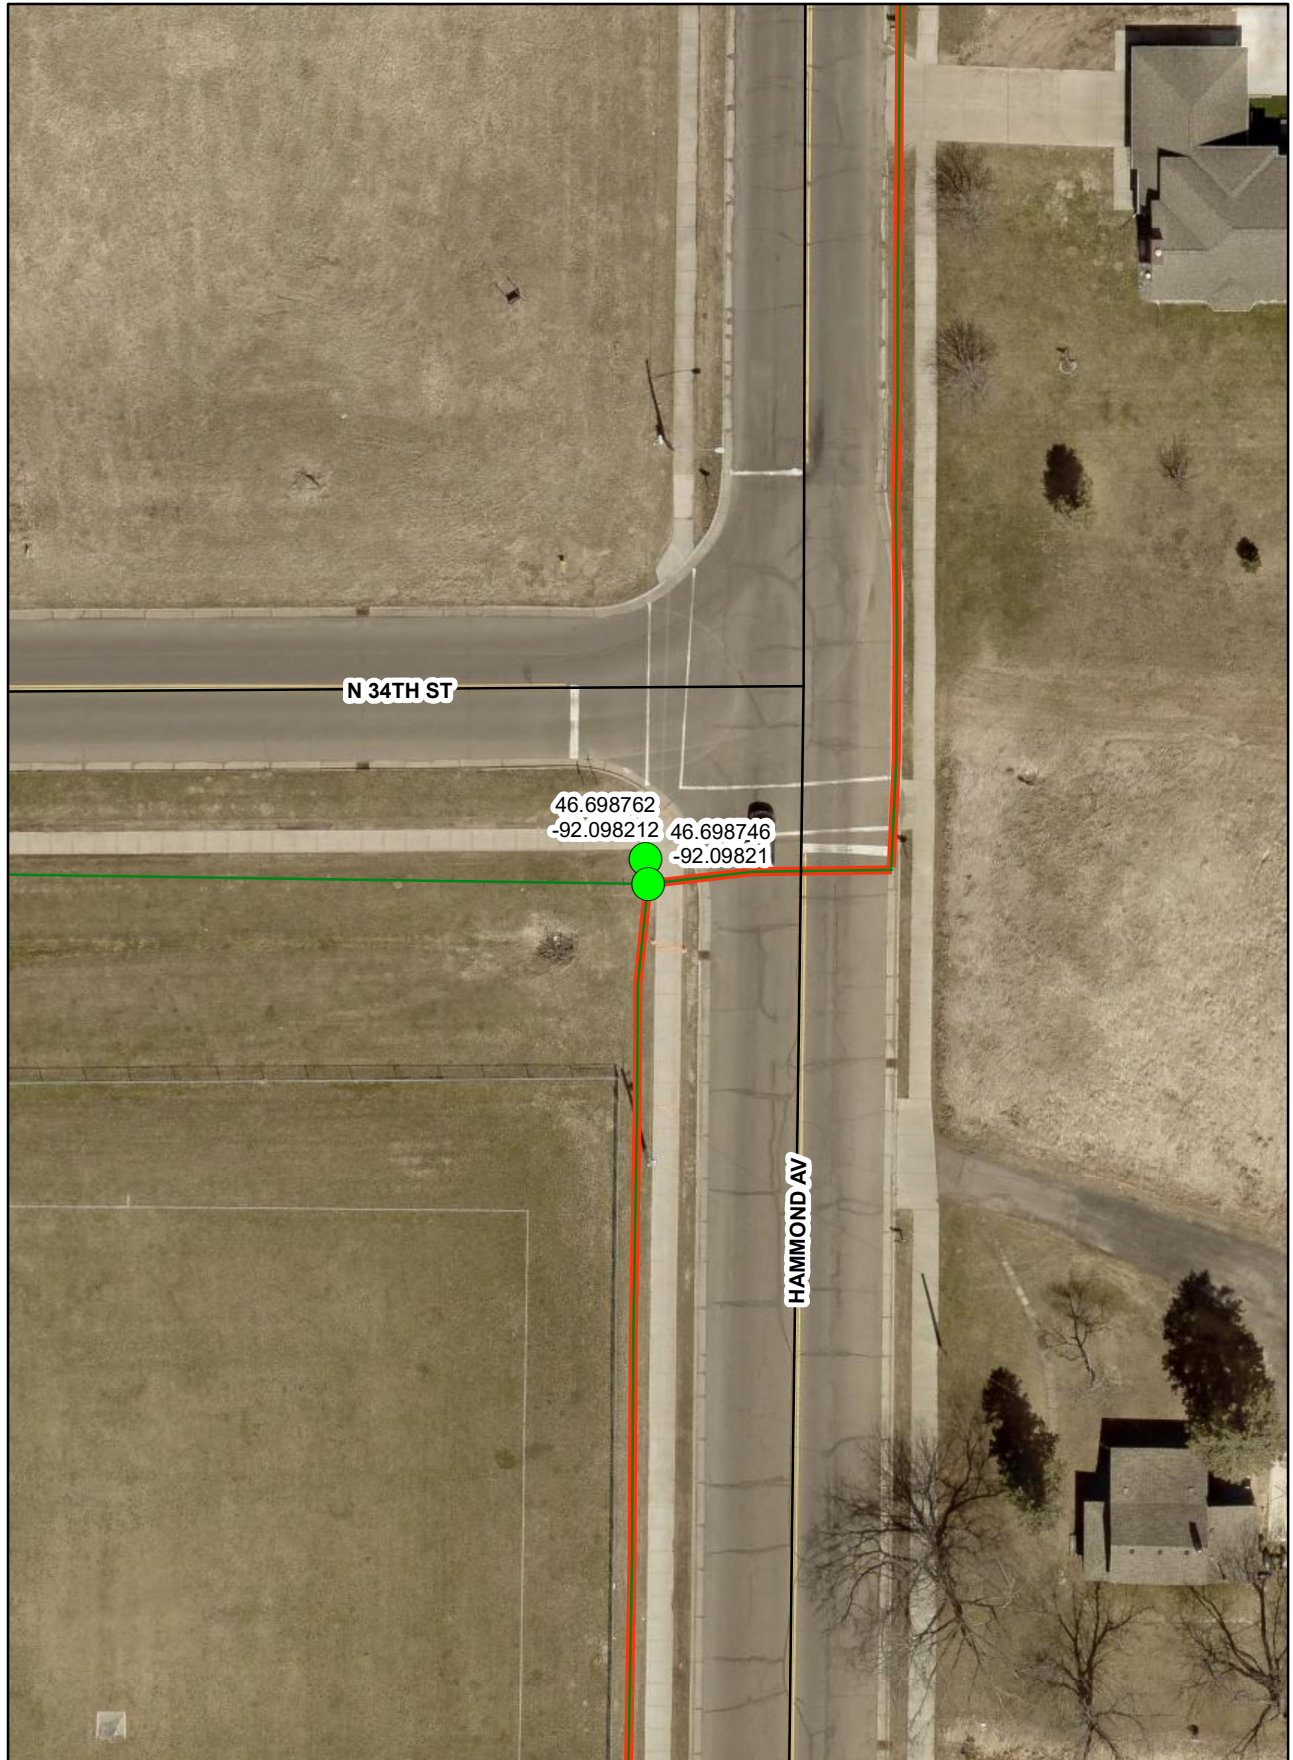

# 1725 N 37th St

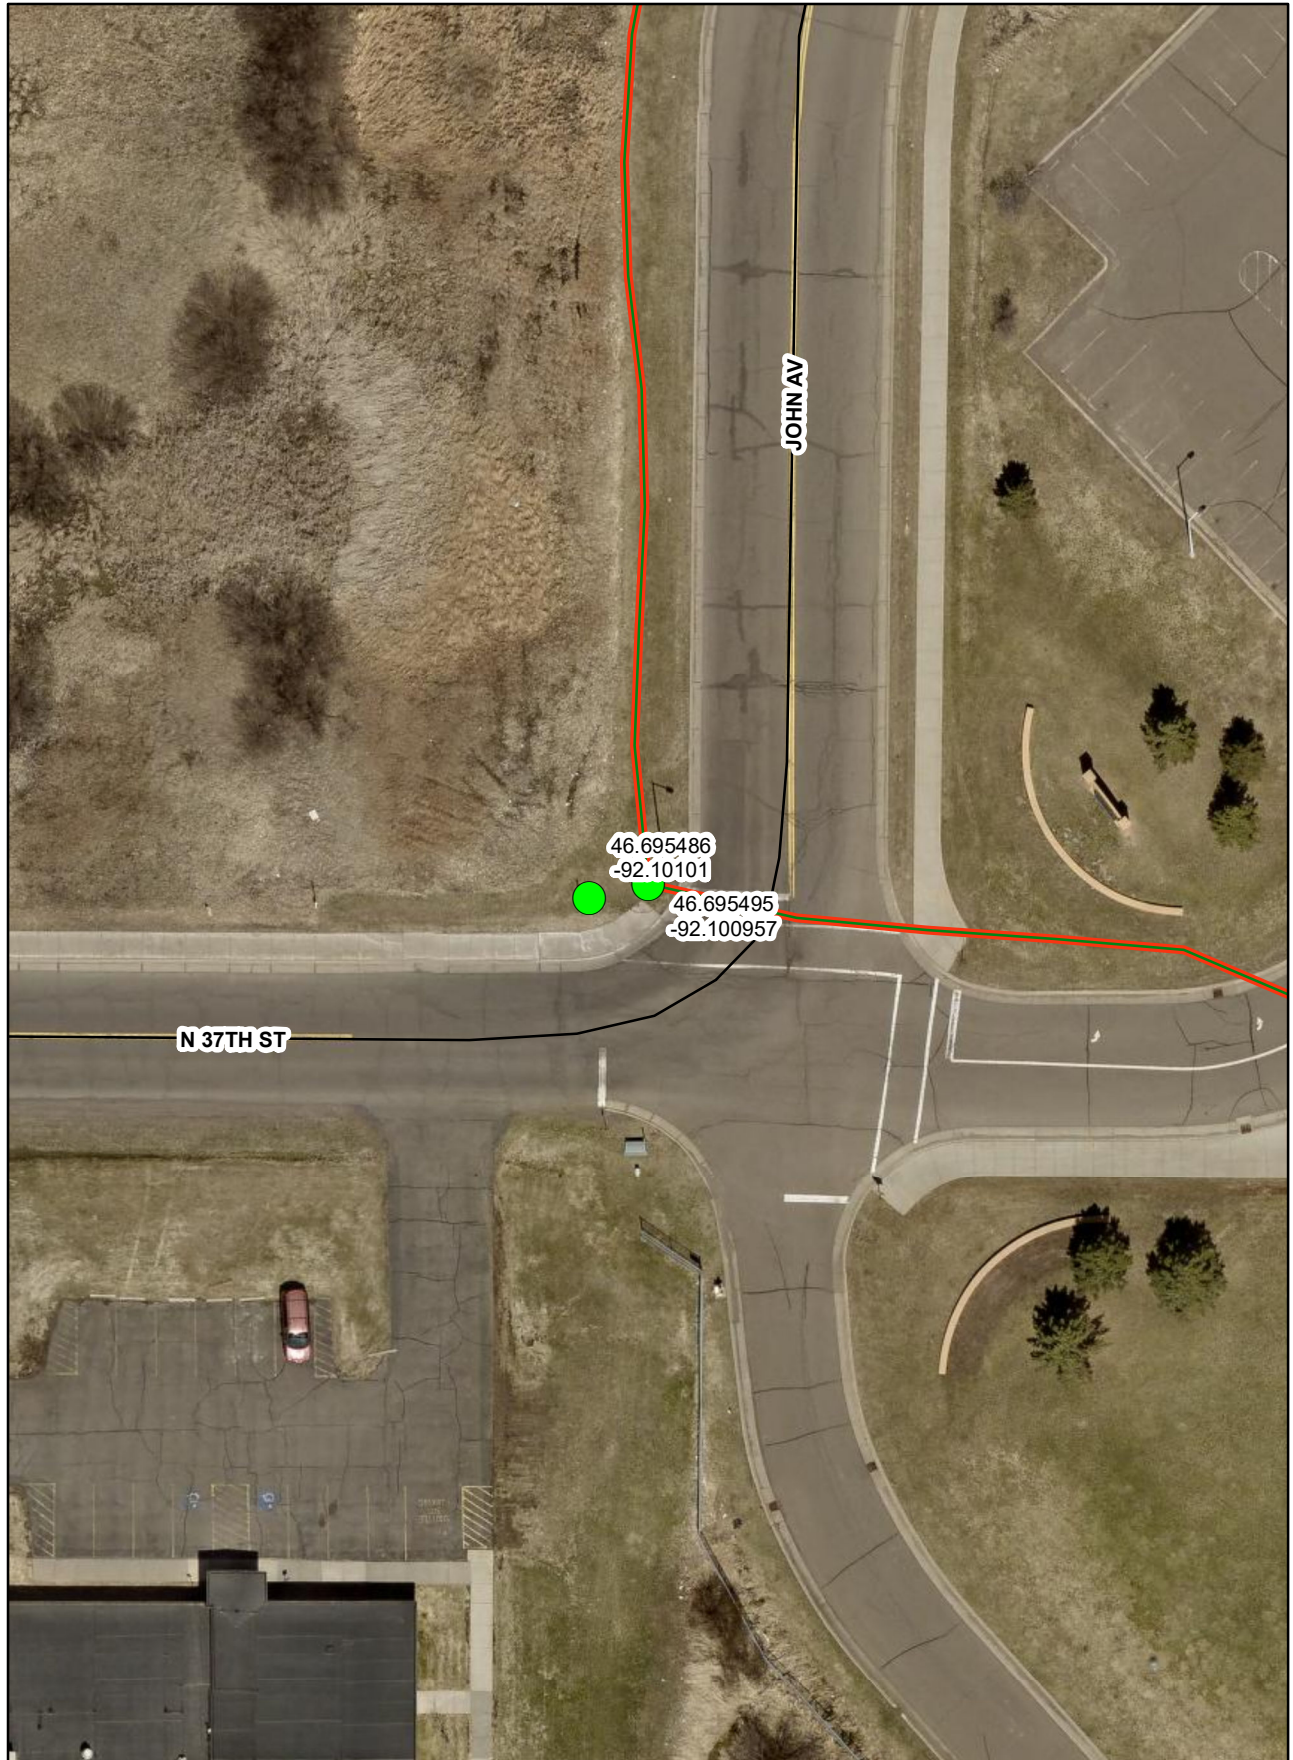

# 1725 N 37th St

